


# CORNER RECORD

Document Number 07-51

City of Lodi

County of San Joaquin, California

Brief Legal Description On CL of Kristen Court shown on 17 M&P 128 and 3 PM 11

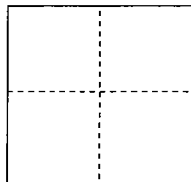

## CORNER TYPE

Government Corner ☐ Control ☐  
Meander ☐ Property ☒  
Rancho ☐ Other ☐

## COORDINATES(Optional)

N. \_\_\_\_\_  
E. \_\_\_\_\_  
Zone \_\_\_\_\_ NAD27 ☐ NAD83 ☐  
NAD83 Epoch \_\_\_\_\_  
Elevation \_\_\_\_\_  
Vert. Datum: NGVD29 ☐ NADV88 ☐  
Meas. Units: Metric ☐ Imperial ☒

Date of Survey October 11, 2007

Corner- Left as found ☐ Found and tagged ☐ Established ☐ Reestablished ☒ Rebuilt ☐

### Identification and type of corner found: Evidence used to identify or procedure used to establish or reestablish the corner:

Set monument well with 3" brass disc stamped "MTCO 2007 LS 8151" to reference position of monument destroyed during

construction of Lower Sacramento Road. Original monument referenced on Corner Record: 07-49

Original monument will not be reset due to location of traffic lanes.

Please see Sketch on Back

### A description of the physical condition of the monument as found and as set or reset:

Monument well with 3" brass disc stamped "MTCO 2007 L 8151"

Please see Sketch on Back

## SURVEYOR'S STATEMENT

This Corner Record was prepared by me or under my direction in conformance with


the Land Surveyor's Act on 12/4/07

Signed

*Matthew J. Stringer*

P.L.S. or R.C.E. No.:

8151

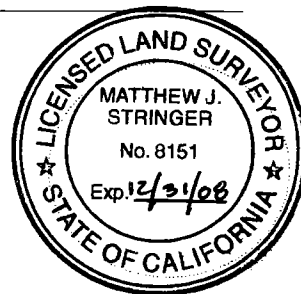

## COUNTY SURVEYOR'S STATEMENT

This Corner Record was received DECEMBER 5, 2007, and examined

and filed DECEMBER 6, 2007

Signed

*Jeff D. Lund*

P.L.S. or R.C.E. No.:

4440



Title

Assistant County Surveyor

County Surveyor's Comment

# LOWER SACRAMENTO ROAD

MON. WAS NOT SET  
ON 1/4 SEC. LINE

## HARTLEY LANE

N00°08'55"W (NORTH)(A)  
329.68' (329.70')(A)

TEHAMA DRIVE

370.30' (370.32')(A)

S89°19'10"E 560.34' (S89°10'15"E)(A)

KRISTEN COURT



(A) per 17 M&P 128

- 1/2" PIN IN MONUMENT WELL PER (A) NOT FOUND DESTROYED DURING CONSTRUCTION
- FOUND 3/4" REBAR IN MONUMENT WELL(A) TAG ILLEGIBLE
- SET 1" X 30" PIPE IN MON WELL WITH ALUMINUM CAP STAMPED "MTCO-2007-LS 8151"

### CORNER RECORD

3/4" PIN ON 17 M&P 128



**MARK THOMAS & COMPANY, INC.**  
Providing Engineering, Surveying, and Planning Services  
7300 Folsom Boulevard, Suite 203  
Sacramento, CA 95826  
(916) 381-9100

DRAWN. BY Matt  
CKD. BY DeLeon  
DATE 10/22/07  
SCALE 1"=40'

APPROVED ON 12/04/07  
BY Matt Stringer  
LS NO.8151 12/31/2008

JOB NO.  
**71-51004**  
FILE NO.

PAGE  
**2** /  
OF  
**2**