


CORNER RECORD

Document Number CR-08-10

City of MANTECA

County of SAN JOAQUIN, California

Brief Legal Description CENTER LINE MONUMENT OF WATSON AVENUE APPROXIMATELY 1235 FEET SOUTH OF YOSEMITE AVENUE AS SHOWN ON FILED PARCEL MAP, 21-PM-166.

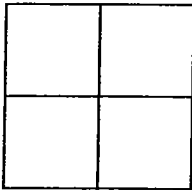

Government Corner ☐ Control ☐
 Meander ☐ Property ☐
 Rancho ☐ Other ☒
 Date of Survey 11-29-07

COORDINATES (Optional)

N. _____
 E. _____
 Zone _____ NAD27 ☐ NAD83 ☐
 NAD83 Epoch _____
 Elev. _____
 Vert. Datum: NGVD29 ☐ NAVD88 ☐
 Meas. Units: Metric ☐ Imperial ☒

Corner - Left as found ☒ Found and tagged ☐ Established ☐ Reestablished ☐ Rebuilt ☐

Identification and type of corner found: Evidence used to identify or procedure used to establish or reestablished the corner:
Centerline Monument - Found 3/4" Iron Pipe, tag illegible, Set two ties as shown on sketch.


A description of the physical condition of the monument as found and as set or reset: _____

Found 3/4" Iron Pipe in monument well in pavement. Tag is illegible.

This Corner Record was prepared by me or under my direction in conformance with the Land Surveyors' Act on December 18th, 2007.

[Signature]

LS 6953

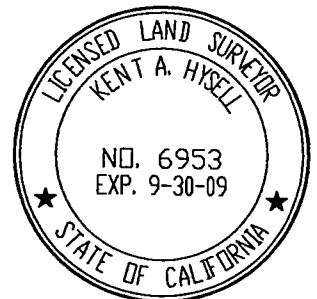

COUNTY SURVEYOR'S STATEMENT

This Corner Record was received JANUARY 8, 2008 and examined and filed JANUARY 11, 2008

Signed [Signature] P.L.S. No. 4440

Title Assistant County Surveyor



County Surveyors Comment _____

