


# CORNER RECORD

Document Number CR 08-14

City of TRACY County of SAN JOAQUIN, California

Brief Legal Description CENTER LINE MONUMENTS ON 10TH STREET INTERSECTING WITH THE INTERSECTION OF E STREET & F STREET AS SHOWN ON FILED PARCEL MAP, 14-PM-52.

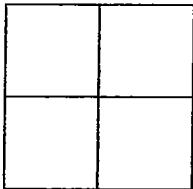

## COORDINATES (Optional)

Government Corner ☐ Control ☐  
 Meander ☐ Property ☐  
 Rancho ☐ Other ☒  
 Date of Survey 12-13-07

N. \_\_\_\_\_  
 E. \_\_\_\_\_  
 Zone \_\_\_\_\_ NAD27 ☐ NAD83 ☐  
 NAD83 Epoch \_\_\_\_\_  
 Elev. \_\_\_\_\_  
 Vert. Datum: NGVD29 ☐ NAVD88 ☐  
 Meas. Units: Metric ☐ Imperial ☒


**Corner** - Left as found ☒ Found and tagged ☐ Established ☐ Reestablished ☐ Rebuilt ☐

Identification and type of corner found: Evidence used to identify or procedure used to establish or reestablished the corner:  
Centerline Monuments - 2 1/2" Brass Disks stamped "LS 4858" in Monument Well. Set two ties as shown on sketch.

A description of the physical condition of the monument as found and as set or reset:  
Found 2 1/2" Brass Disks stamped "LS 4858" in Monument Wells in pavement.

This Corner Record was prepared by me or under my direction in conformance with the Land Surveyors' Act on January 8th, 2008.

Signed [Signature] L.S. LS 6953

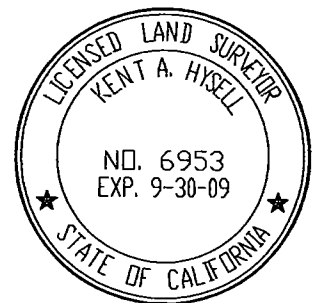

## COUNTY SURVEYOR'S STATEMENT

This Corner Record was received JANUARY 15, 2008 and examined and filed JANUARY 17, 2008.

Signed [Signature] P.L.S. No. 4440

Title Assistant County Surveyor

**County Surveyors Comment** \_\_\_\_\_

