
CORNER RECORD Document Number_ CR. 08-79 City of _____ County of San Joaquin, California Brief Legal Description JACK TONE ROAD WEST 1/4 CORNER SECTION 6 **CORNER TYPE** COORDINATES (Optional) Control NAD27 ☐ NAD83 ☐ Meander Property NAD83 Epoch_ Rancho Other Elev. Vert. Datum: NGVD29 □ NAVD88 □ Date of Survey June 16, 2005 Meas. Units: Metric Imperial 🛛 TIN R8E Corner -Left as found Found and tagged Established □ Reestablished Rebuilt Identification and type of corner found: Evidence used to identify or procedure used to establish or reestablish the corner: SEE SKETCH ON BACKSIDE. A description of the physical condition of the monument as found and as set or reset: SEE SKETCH ON BACKSIDE. SURVEYOR'S STATEMENT This Corner Record was prepared by me or under my direction in conformance with the Land Surveyors' Act on Feb. 14 Signed Menul Solstis R.C.E. Number <u>C30890</u> COUNTY SURVEYOR'S STATEMENT This Corner Record was received <u>Feb.</u> 15 _, 2008 and examined and filed ___ Feb. Signed _____ P.L.S. No. <u>4440</u> Title Assistant County Surveyor County Surveyor's Comment No. 4440 THIS CORNER RECORD IS NOT IN COMPLIANCE WITH BOARD RULE 464(C) Expires REGARDING SUBMITTAL WITHIN 90 DAYS FROM THE DATE OF SURVEY.

(D.D. Sheet No. 38

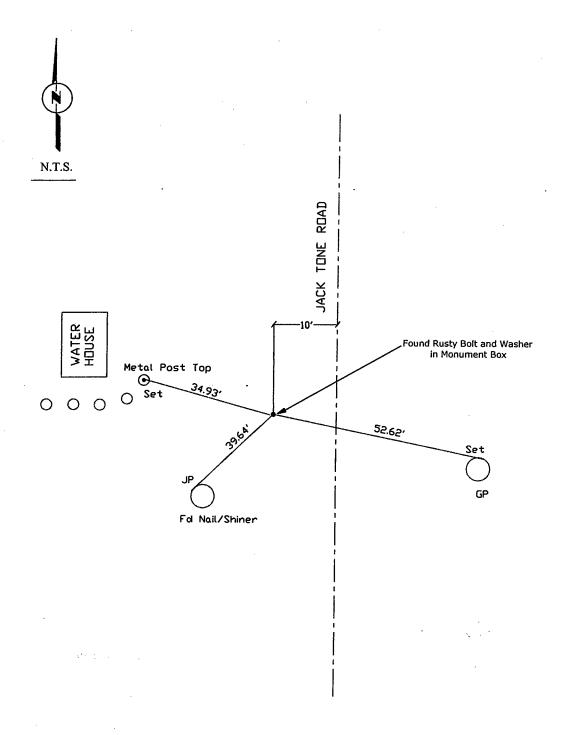

Note: Found Monuments are not tagged unless otherwise noted.

"No Attempt Was Made to Verify the Monument(s)"

FP=Fence Post
GP=Guy Post
JP=Joint Pole
PP=Power Pole
SP=Service Pole
TP=Telephone Pole
S.F.N=Searched Found Nothing
N.T.S.=Not To Scole
Set=Conc. Nail with Brass Washer Stamped
"S.J. Co.", unless otherwise noted

Note: Set Ties are Brass Washers Stamped "S.J.Co. PUBLIC WORKS"