
CORNER RECORD				Document NumberCF-08-103			
City of					San Joaquin,	California	
Brief Legal Description	CHRISMAN ROAD @	DURHAM FERRY F	ROAD				
	CORNER TYPE			COORDINATES (Optional)			
.15. 14	Government Corr			E Zone	NAD27	□ NAD83 □	
22 23	Rancho Date of Survey	☐ Other		Elev Vert. Datu	m: NGVD29 🗆	NAVD88	
T3\$ R5E	Date of Solvey	JOI 16 20, 2000		Meas. Unit	ts: Metric 🗆	Imperial 🛚	
Corner - Left as fo	ound 🛛 Found and	tagged 🔲 Es	tablished [] Reestab	lished 🔲 Reb	uilt 🗆	
Identification and type SEE SKETCH ON BACKS		dence used to ide	entify or proc	edure used to	establish or reesto	ablish the corne	
A description of the pt	SIDE	e monument as fo					
					_		
This Corner Record wa: the Land Surveyors' A		under my directio		ance with	PROFESS/	ONAL CHISINE	
Signed Manua	1 / .	_ R.C.E. Numbe			Proces 3/3	1/20/00	
	OUNTY SURVEYOR'S				TE OF GALL	FORM	
This Corner Record wand filed	_	<u> 24</u> , 2 , 2008.	008 and ex	amined	Manuel 1	Mori	
igned	1 Alm	P.L.S	. No. <u>4440</u>	·····	NAL L	ANO	
itle <u>Assistant Coun</u>	ty Surveyor				(S) 44 D.	LUNE	
County Surveyor's Co THIS CORNER RECORD		CE WITH BOARD F	RULE 464(c)	 	No. 44 Expire	ا الحد ا	
REGARDING SUBMITTA					9-30-		
					WYE OF	TEORIT	

(D.D. Sheet No. 68)

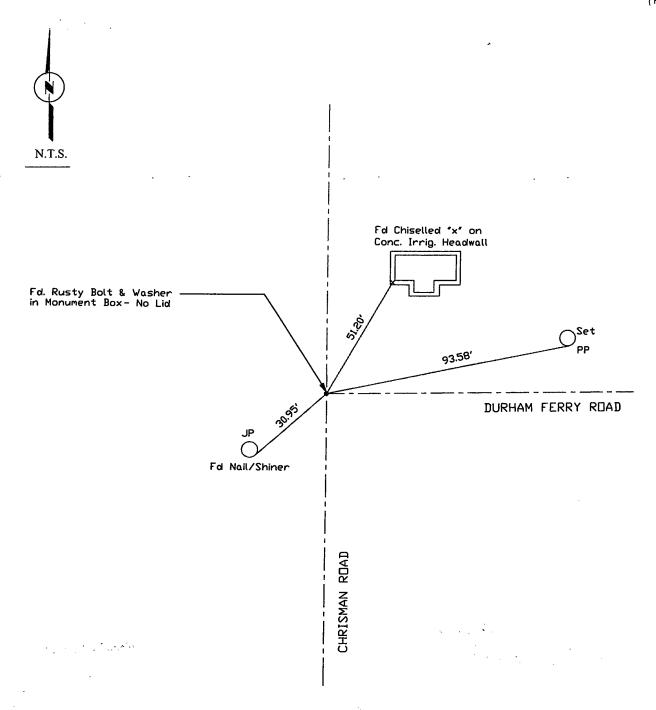

Note: Found Monuments are not tagged unless otherwise noted.

"No Attempt Was Made to Verify the Monument(s)"

FP=Fence Post
GP=Guy Post
JP=Joint Pole
PP=Power Pole
SP=Service Pole
TP=Telephone Pole
S.F.N=Searched Found Nothing
N.T.S.=Not To Scale
Set=Conc. Noil with Brass Washer Stamped
"S.J. Co.", unless otherwise noted

Note: Set Ties are Brass Washers Stamped "S.J.Co. PUBLIC WORKS"