


# CORNER RECORD

Document Number CR-08-133  
 City of UNINCORPORATED County of San Joaquin, California  
 Brief Legal Description LOT 5 OF "LIBERTY ACRES" #3 MAP 13-76 S.J.C.R.

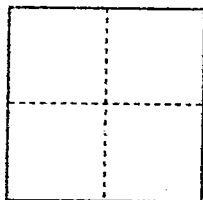

## CORNER TYPE

Government Corner ☐ Control ☐  
 Meander ☐ Property ☒  
 Rancho ☐ Other ☐

Date of Survey APRIL 14  
2008

## COORDINATES (Optional)

N. \_\_\_\_\_  
 E. \_\_\_\_\_  
 Zone \_\_\_\_\_ NAD27 ☐ NAD83 ☐  
 NAD83 Epoch \_\_\_\_\_  
 Elev. \_\_\_\_\_  
 Vert. Datum: NGVD29 ☐ NAVD88 ☐  
 Meas. Units: Metric ☐ Imperial ☒

Corner - Left as found ☐ Found and tagged ☐ Established ☐ Reestablished ☒ Rebuilt ☐

Identification and type of corner found: Evidence used to identify or procedure used to establish or reestablish the corner:

PROVISED BETWEEN FOUND POINTS ON LINE SEE PLAT ON BACK

A description of the physical condition of the monument as found and as set or reset: 3/4" REBAR 30"  
CONG TAGGED LS 8080

## SURVEYOR'S STATEMENT

This Corner Record was prepared by me or under my direction in conformance with the Land Surveyors' Act on APRIL 16, 2008.

Signed \_\_\_\_\_ L.S. or R.C.E. Number 8080




## COUNTY SURVEYOR'S STATEMENT

This Corner Record was received May 8<sup>TH</sup>, 2008 and examined and filed May 15<sup>TH</sup>, 2008.

Signed John G. May  
 Title DEPUTY Assistant County Surveyor

P.L.S. No. ~~4440~~  
6186

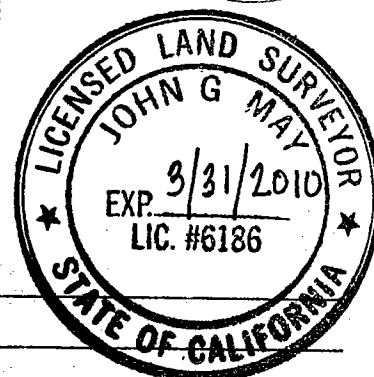

County Surveyor's Comment \_\_\_\_\_

(D.D. Sheet No. 12)

D.B. Wilton

LAND SURVEYING

PO BOX 435 LODI CA 95241-0435  
(209) 747-0169 dbwsurvey@yahoo.com



# NORTH CHEROKEE LANE

S88°57'57"E 1293.90' (M) 1293.6'(R)

LOT 5

S88°58'04"E 1294.69'(M) 1294.45'(R)

BASIS OF BEARINGS: THE WEST LINE OF THE EAST 1/2 OF THE  
NORTHEAST 1/4 OF SECTION 1 T. 4 N., R. 6 E., M. D. B. & M.  
BEING S 0°18' 30" W, AS SHOWN ON (R)

—●— FOUND 3/4" IRON PIN TAGGED "LS 2273"  
AS PER (R) UNLESS OTHERWISE NOTED

SET 3/4" DIA. BY 30" LONG  
REBAR TAGGED L.S. 8080  
DENOTED —O— UNLESS OTHERWISE NOTED

## REFERENCE:

(R) "LIBERTY ACRES NO. 3"  
MAPS AND PLATS 13-76, S.J.C.R.  
(M) MEASURED DATA

FOUND 1" IRON PIN  
TAGGED "LS 2273" AT  
1/4 1/4 CORNER (R)

300.15'(M)  
300.0'(R)

N00°09'27"E  
300.12'(M)  
300.0'(R)

N00°18'30"E (BASIS) 1646.32'(M) 1645.5'(R)

SCALE  
1"=200'