


CORNER RECORD

City of UNINCORPORATED Document Number CR-08-134
 County of San Joaquin, California

Brief Legal Description LOT 4 OF "SIMI ESTATES MAP 40-83 S.J.C.R."
TRACT # 3534

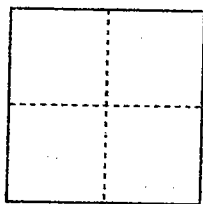

CORNER TYPE

Government Corner ☐ Control ☐
 Meander ☐ Property ☒
 Rancho ☐ Other ☐

Date of Survey 4-21-08

COORDINATES (Optional)

N. _____
 E. _____
 Zone _____ NAD27 ☐ NAD83 ☐
 NAD83 Epoch _____
 Elev. _____
 Vert. Datum: NGVD29 ☐ NAVD88 ☐
 Meas. Units: Metric ☐ Imperial ☒

Corner - Left as found ☐ Found and tagged ☐ Established ☐ Reestablished ☒ Rebuilt ☐

Identification and type of corner found: Evidence used to identify or procedure used to establish or reestablish the corner:

TURNED RECORD ANGLE & DISTANCE FROM FOUND CORNERS
CHECKED INTO 3RD CORNER. SEE PLAT ON BACK

A description of the physical condition of the monument as found and as set or reset: SET 3/4" REBAR
30" LONG CAPPED "LS 8080"

SURVEYOR'S STATEMENT

This Corner Record was prepared by me or under my direction in conformance with
 the Land Surveyors' Act on APRIL 26TH, 2008.

Signed [Signature] L.S. or R.C.E. Number 8080

COUNTY SURVEYOR'S STATEMENT


This Corner Record was received May 8TH, 2008 and examined
 and filed May 15TH, 2008

Signed John G. May
 Title DEPUTY Assistant County Surveyor

P.L.S. No. 4440


6186

County Surveyor's Comment _____

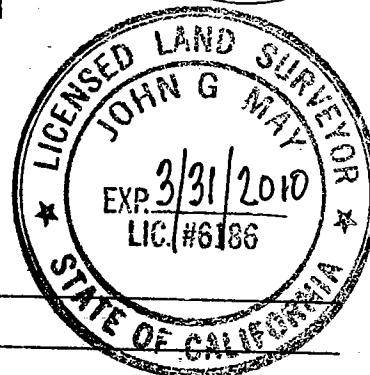

(D.D. Sheet No. 27)

SCALE 1"=50'

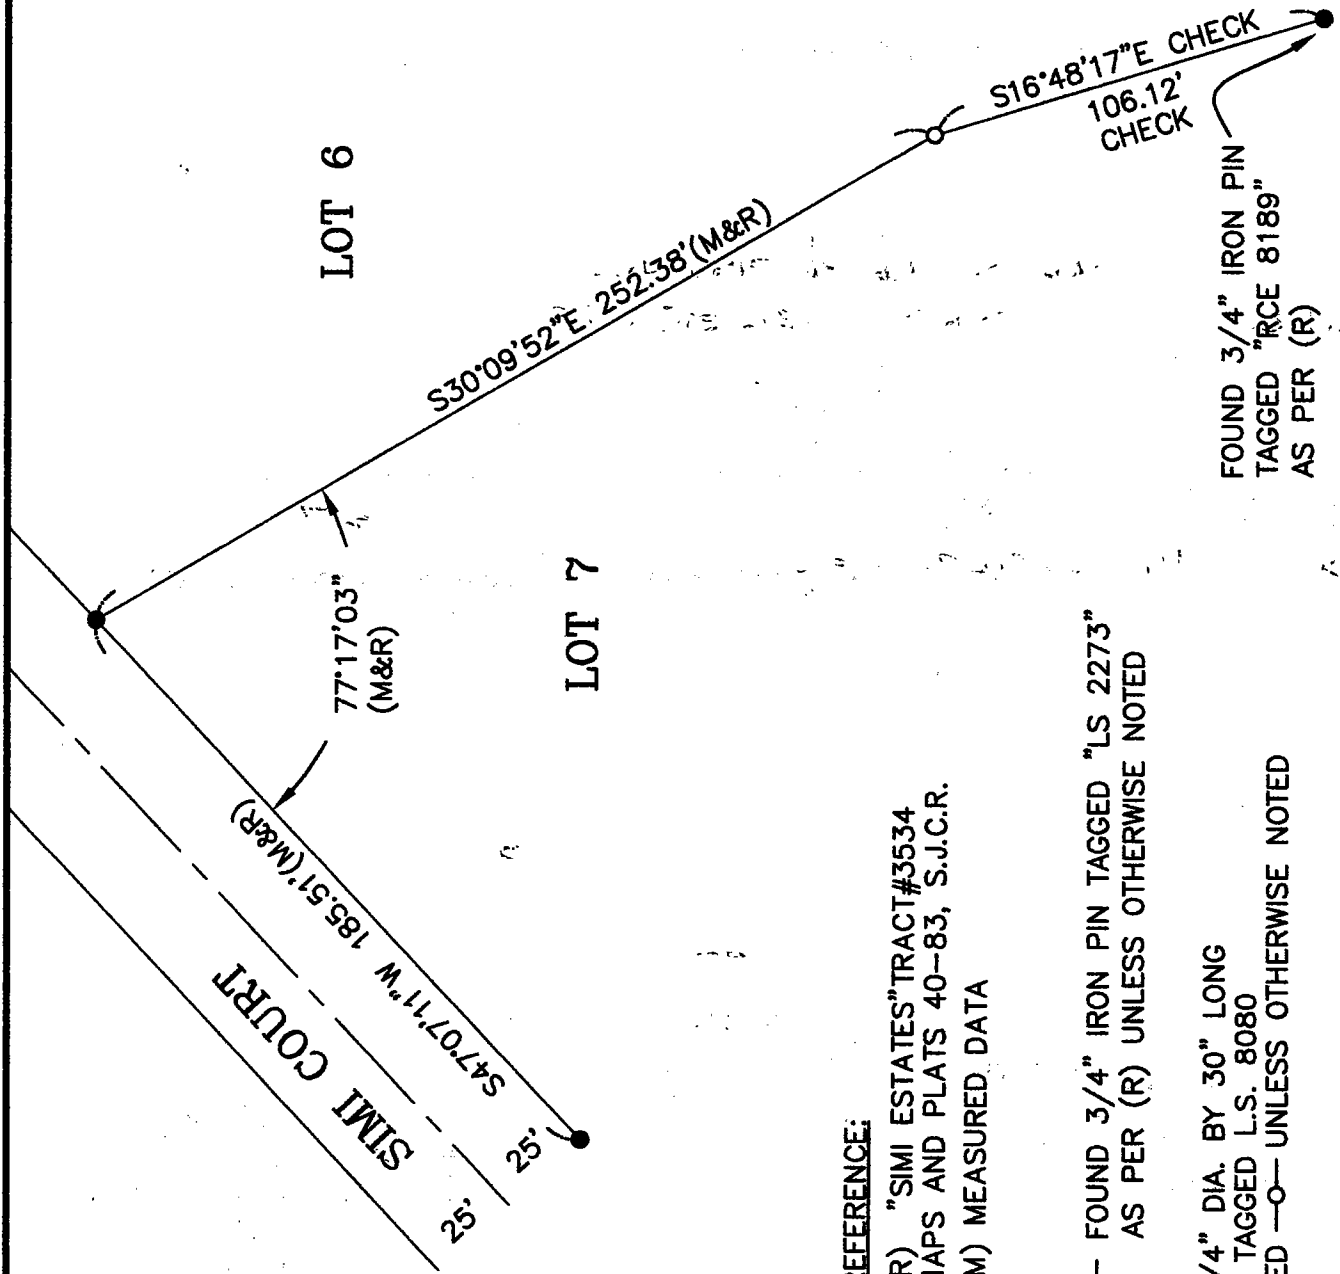

REFERENCE:

(R) "SIMI ESTATES" TRACT #3534
MAPS AND PLATS 40-83, S.J.C.R.
(M) MEASURED DATA

—●— FOUND 3/4" IRON PIN TAGGED "LS 2273"
AS PER (R) UNLESS OTHERWISE NOTED

SET 3/4" DIA. BY 30" LONG
REBAR TAGGED L.S. 8080
DENOTED —O— UNLESS OTHERWISE NOTED

D.B. Wilton

LAND SURVEYING

PO BOX 435 LODI CA 95241-0435
(209) 747-0169 dbwilton@yahoo.com