
CORNER RECORD		Document Numb	5-140	
City of		County of	San Joaquin,	Californic
Brief Legal Description	CHERRYLAND AVENUE @ VERONICA STREET			
	CORNER TYPE		ORDINATES (Op	tional)
	Government Corner □ Control □ Meander □ Property □ Rancho □ Other ☒	Zone NAD83 Epoc	NAD27 h	□ NAD83 □
	Date of Survey April 15, 2008	Elev Vert. Datum: Meas. Units:	NGVD29 □	
Corner - Left as for	und 🛛 Found and tagged 🔲 Established	☐ Reestablish	ed 🗆 Reb	uilt 🔲
Identification and type	e of corner found: Evidence used to identify or p	rocedure used to e	stablish or reest	ablish the come
SEE SKETCH ON BACKS	ine `			
	,			
SEE SKETCH ON BACKSI	nysical condition of the monument as found and IDE.			
	SURVEYOR'S STATEMENT		PROFESSION	
	s prepared by me or under my direction in confo	ormance with	E PHOTO OF	ENGINE
	Act on <u>May 9</u> , 2008.	((:	No. C30890	1 678 11
Signed Monuel	R.C.E. Number <u>C30890</u>) <u> </u>	STATE OF CALIFO	etill.
	OUNTY SURVEYOR'S STATEMENT		F OF CALIFO	
This Corner Record wand filed May	vas received <u>May 10</u> , 2008 and 15, 2008.	examined	Manuella	MANS
Signed John	G. May P.L.S. No. 6	186	0	AND C
Title Deputy County	y Surveyor (WSED H	N G MARKE
County Surveyor's Co	omment		EXP.	3/31/2010
				
(D.D. Sheet No. 32A) (Job No. 220575)			EOI	CALIFORNIT

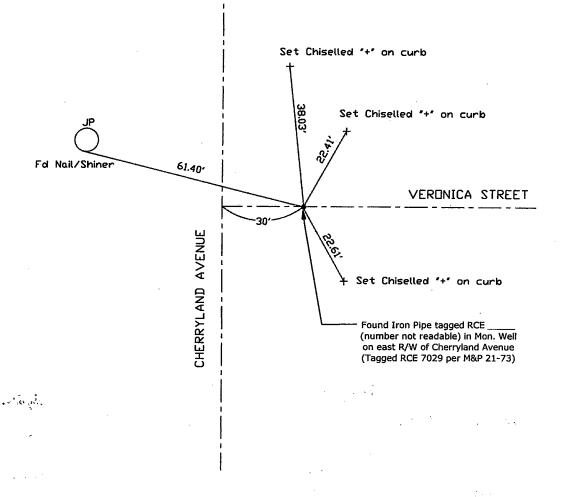



Note: Found Monuments are not tagged unless otherwise noted.

"No Attempt Was Made to Verify the Monument(s)"

FP=Fence Post
GP=Guy Post
JP=Joint Pole
PP=Power Pole
SP=Service Pole
TP=Telephone Pole
S.F.N=Searched Found Nothing
N.T.S.=Not To Scale
Set=Conc. Nail with Brass Washer Stamped
"S.J. Co.", unless otherwise noted

Note: Set Ties are Brass Washers Stamped "S.J.Co. PUBLIC WORKS"