
CORNER RECORD		Do	Document Number CF-08-151				
City of			ounty of	San Joaqu			
Brief Legal Description	GAWNE ROAD	·					
	WEST QUARTER CORNER OF SEC. 32						
	CORNER TYPE			COORDINATES (Optional)			
22	Government Corner ☑ Control ☐ Meander ☐ Property ☐		zone	NA	D27 🗆 NAD83 🗆		
	Rancho 🗆 Other 🗆		NAD83 Epo	ch			
TIN R9E	Date of Survey February 14, 2007		Vert. Datum Meas. Units:	n: NGVD29 Metric	□ NAVD88 □ □ Imperial ☑		
Corner - Left as fo	bund 🛛 Found and tagged 🔲 Established	 	Reestablis	hed 🔲 🗆	Rebuilt 🔲		
Identification and type	e of corner found: Evidence used to identify or	oroce	dure used to (establish or re	establish the corne		
SEE SKETCH ON BACKS	SIDE.						
				- ·			
			w	· · · · · · · · · · · · · · · · · · ·			
	nysical condition of the monument as found and		t or reset:				
FOUND MONUMENT IN	GOOD CONDITION. SEE SKETCH ON BACKSIDE						
							
	SURVEYOR'S STATEMENT				PROFESSIONAL		
This Corner Record wa	s prepared by me or under my direction in cont	ormar	nce with		ARDEL COORD CE		
	Act on June 25 , 2008.			EBISTE,	No. C30890		
Signed_ <i>Manu</i>		n		\\ * \	Pires 3/31/2003		
		<u> </u>	-	93	FIF OF CALIFORNIE		
Corner Record w	vas received July 3 ^{PD} , 2008 and	Lovan	ainad		Ponvel Dani		
and filed <u>July</u>	7 3 RD , 2008.	exur	imied .	///	onverzes in		
Signed	nG. May L.S. No.	186					
Title Deputy County	y Surveyor (O LAN	ID SU		
				NS HN	3 MARCH		
County Surveyor's Co THIS CORNER RECORD	omment IS NOT IN COMPLIANCE WITH BOARD RULE 464([<u>\$</u>	SED LAN OHN (1/2/2/2		
	L WITHIN 90 DAYS FROM THE DATE OF SURVEY.	~		EXP.	31/2010		
				LIC. #	6186		
D.D. Sheet No. 40) Job No. 750108)							

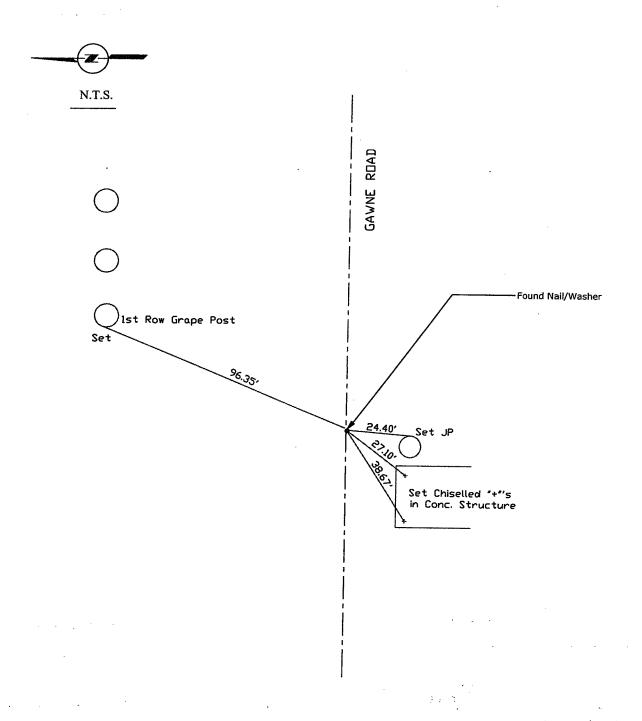

Note: Found Monuments are not tagged unless otherwise noted.

"No Attempt Was Made to Verify the Monument(s)"

FP=Fence Post
GP=Guy Post
JP=Joint Pole
PP=Power Pole
SP=Service Pole
TP=Telephone Role
S.F.N=Searched Found Nothing
N.T.S.=Not To Scale
Set=Conc. Nail with Brass Washer Stamped
"S.J. Co.", unless otherwise noted

Note: Set Ties are Brass Washers Stamped "S.J.Co. PUBLIC WORKS"