


CORNER RECORD

City of Ripon Document No. CR-08-158
County of San Joaquin, California

Brief Legal Description Intersection of The centerline of Washington St. (Curve Way) with the projected westerly R/W Key Ave.

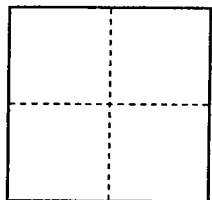

CORNER TYPE

Government Corner ☐ Control ☒
Meander ☐ Property ☐
Rancho ☐ Other ☐

Date of Survey JAN 9, 2008

COORDINATES (Optional)

N.
E.
Zone NAD27 NAD83
NAD83 Epoch
Elev.
Vert. Datum: NGVD29 NAVD88
Meas. Units: Metric ☐ Imperial ☐

Corner - Left as found ☐ Found and tagged ☒ Established ☐ Reestablished ☐ Rebuilt ☐

Identification and type of corner found: Evidence used to identify or procedure used to establish or reestablish the corner:

Found 1/2" Pipe 2.0' deep
SET TAG L.S. 4450 ON TOP

A description of the physical condition of the monument as found and as set or reset:

Found 1/2" Pipe 2.0' deep
SET TAG L.S. 4450 ON TOP

SURVEYOR'S STATEMENT

This Corner Record was prepared by me or under my direction in conformance with the Land Surveyors' Act on JUNE 30, 2008.


Signed Michael L. Quatani S. or R.C.E. Number LS 4450

COUNTY SURVEYOR'S STATEMENT

This Corner Record was received JULY 1, 2008 and examined and filed JULY 11, 2008.

Signed John G. May P.L.S. No. 4440
Title Deputy County Surveyor 6186

County Surveyor's Comment This corner record is not in compliance with Board Rule 464 (e) regarding Submittal within 90 days from the date of survey.
(D.D. Sheet No. 60)

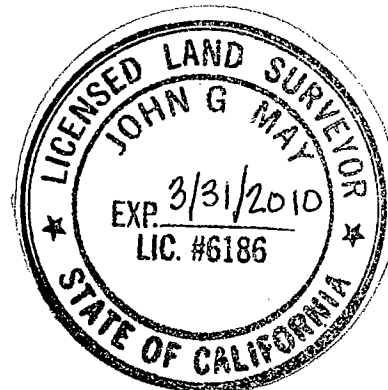

Ripon A

MAPS & PLATS 7-13

