


7/15/08

# CORNER RECORD

Document Number CR-08-162  
County of San Joaquin, California

City of \_\_\_\_\_  
Brief Legal Description HEWITT ROAD NW CORNER SECTION 7

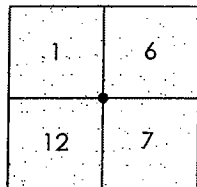

T1N R8E T1N R9E

## CORNER TYPE

Government Corner ☒ Control ☐  
Meander ☐ Property ☐  
Rancho ☐ Other ☐  
Date of Survey June 20, 2008

## COORDINATES (Optional)

N. \_\_\_\_\_  
E. \_\_\_\_\_  
Zone \_\_\_\_\_ NAD27 ☐ NAD83 ☐  
NAD83 Epoch \_\_\_\_\_  
Elev. \_\_\_\_\_  
Vert. Datum: NGVD29 ☐ NAVD88 ☐  
Meas. Units: Metric ☐ Imperial ☒

Corner - Left as found ☐ Found and tagged ☐ Established ☐ Reestablished ☐ Rebuilt ☒

Identification and type of corner found: Evidence used to identify or procedure used to establish or reestablish the corner:  
SEE SKETCH ON BACKSIDE.

A description of the physical condition of the monument as found and as set or reset: \_\_\_\_\_  
SEE SKETCH ON BACKSIDE.

## SURVEYOR'S STATEMENT

This Corner Record was prepared by me or under my direction in conformance with the Land Surveyors' Act on July 10, 2008.

Signed Manuel Solord R.C.E. Number C30890

## COUNTY SURVEYOR'S STATEMENT

This Corner Record was received JULY 15 TH, 2008 and examined and filed JULY 18 TH, 2008.

Signed John G. May P.L.S. No. 6186  
Title Deputy County Surveyor

County Surveyor's Comment \_\_\_\_\_

(D.D. Sheet Nos. 39 & 40)  
(Job No. 220741)




Manuel Solord





N.T.S.

Set 2" x 2" Hub & Tack in  
Monument Well @ location  
of RR Spike per CR 08-49

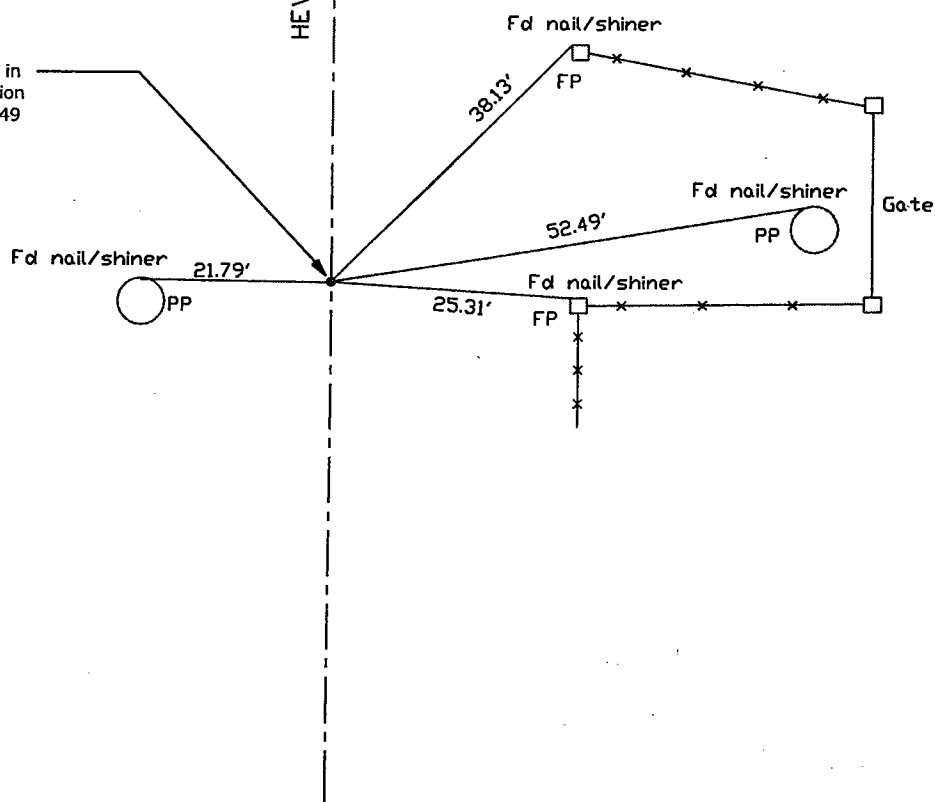

Note: Found Monuments are not tagged  
unless otherwise noted.

"No Attempt Was Made to Verify the Monument(s)"

FP=Fence Post  
GP=Guy Post  
JP=Joint Pole  
PP=Power Pole  
SP=Service Pole  
TP=Telephone Pole  
S.F.N=Searched Found Nothing  
N.T.S.=Not To Scale  
Fd=Conc. Nail with Brass Washer Stamped  
"S.J. Co.", unless otherwise noted

Note: Found Ties are Brass Washers  
Stamped "S.J.Co. PUBLIC WORKS"  
per CR 08-49, unless otherwise noted