
7/15/08

CORNER RECORD

			Document Number CF-08 · [G]		
City of			County of	San Joaquin,	California
Brief Legal Description	on ARMSTRONG ROAD				
	NORTHWEST CORNER OF SI	EC. 26			
	CORNER TYPE		COORDINATES (Optional)		
26	Government Corner Meander Rancho	Property 🗆	Zone NAD83 Epo Elev	NAD27	□ NAD83 □
T3N R6E	Date of Survey <u>May 2</u>	, 2006	Vert. Datu	m: NGVD29 🗆 s: Metric 🗆	NAVD88 □ Imperial 🏻
Corner - Left as	found 🛛 Found and tagge	d ☐ Established	☐ Reestabl	ished 🔲 Reb	uilt 🔲
SEE SKETCH ON BAC	pe of corner found: Evidence KSIDE.	used to identity or p		,	
	physical condition of the mon-		as set or reset:		
	SURVEYOR'S STATEMENT was prepared by me or under it. Act on July 10 R.C.			PROFESSION OF THE PROPERTY OF	Lab A
This Corner Record	~ 10 TH-		examined	Manuell	
Signed	oth G. May	L.S. No61	86	SED LAN	D SUP
County Surveyor's (THIS CORNER RECOR	Comment RD IS NOT IN COMPLIANCE WIT	H BOARD RULE 464(c)	2/20	2010
REGARDING SUBMITT	AL WITHIN 90 DAYS FROM THE	DATE OF SURVEY.		EXP. 3/3/ LIC. #6	186
D.D. Sheet No. 15					

4

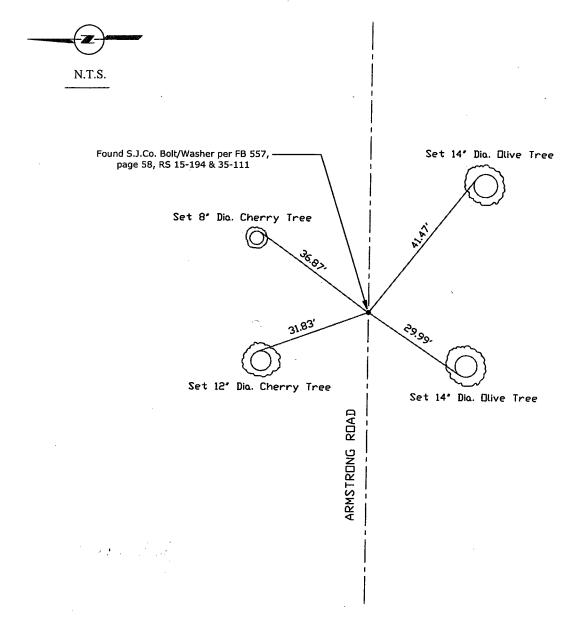

Note: Found Monuments are not tagged unless otherwise noted.

"No Attempt Was Made to Verify the Monument(s)"

FP=Fence Post
GP=Guy Post
JP=Joint Pole
PP=Power Pole
SP=Service Pole
TP=Telephone Pole
S.F.N=Searched Found Nothing
N.T.S.=Not To Scale
Set=Conc. Nail with Brass Washer Stamped
"S.J. Co.", unless otherwise noted

Note: Set Ties are Brass Washers Stamped "S.J.Co. PUBLIC WORKS"