

CURNER RECC	JRD	Document Number <u>CR-09-10</u>
City of		County of San Joaquín, Californic
Brief Legal Description _	LA SALLE DRIVE 586' WEST OF GILBEAU COUR	RT IN TOWN OF WOODBRIDGE
	(WITHIN SECTION 34, TOWNSHIP 4 NORTH, RAI	NGE 6 EAST)
	CORNER TYPE	COORDINATES (Optional)
	Government Corner Control	N E
	Meander □ Property □	ZoneNAD27 🗆 NAD83 🗖
	Rancho 🗆 Other 🗵	NAD83 Epoch Elev
	Date of Survey November 17, 2008	Vert. Datum: NGVD29 □ NAVD88 □ Meas. Units; Metric □ Imperial ☑
Corner - Left as fou	and ☑ Found and tagged ☐ Established	☐ Reestablished ☐ Rebuilt ☐
Identification and type SEE SKETCH ON BACKSIE)E	rocedure used to establish or reestablish the corner
SEE SKEICH ON BACKSIL	JE.	

A description of the phy	usical condition of the manument as found and	as set or reset:
SEE SKETCH ON BACKSIE		us set of feset
SEE SKETCH ON BACKSIE		***************************************
<u> </u>		
	SURVEYOR'S STATEMENT	ONALLANO
This Corner Record was	prepared by me or under my direction in confo	ormance with
the Land Surveyors' Ac	ct on 1/14/09 2008.	空间
Signed 75	P.L.S. Number <u>8470</u>	LICENSE EIO
signed /	1.L.S. NORIBEI <u>64/0</u>	No. 8470
18	SUNTY SURVEYOR'S STATEMENT	examined 87 12/31/2010
	as received JANUARY 15, 2008 and	examined 8, 12/31/2
and filed JANG	1ART 23 ,2009.	examined OF CALIFORNIA
Signed oh	G. May P.L.S. No. 61	186
Title Deputy County	V	T LAND S
	<u> </u>	SS CON G DEPL
County Surveyor's Cor	mment	3/9 32/2
, ,		3 31 2010
		X LXK HARING X
		[2. Land 1.2]
(D.D. Sheet No. 12A)		
(Job No. 220772)		OF CALL

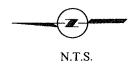

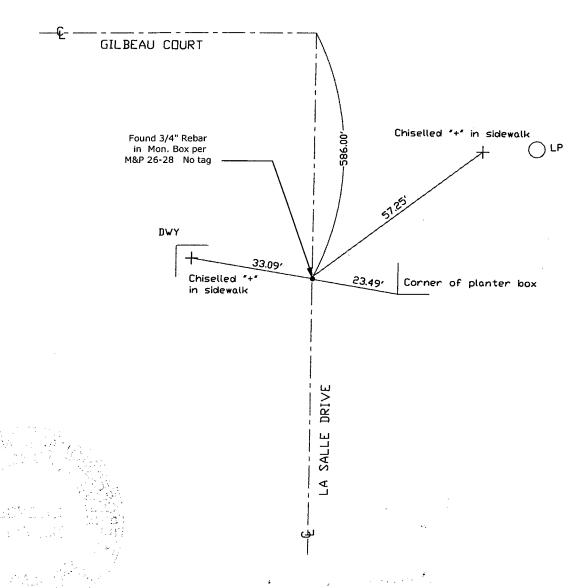

Note: Found Monuments are not tagged unless otherwise noted.

"No Attempt Was Made to Verify the Monument(s)"

DWY=Driveway
FP=Fence Post
GP=Guy Post
JP=Joint Pole
LP=Lomp Pole
PP=Power Pole
RS=Record of Survey
SP=Service Pole
TP=Telephone Pole
S.F.N=Searched Found Nothing
N.T.S.=Not To Scale
Set=Conc. Noil with Brass Washer Stamped
"S.J. Co.", unless otherwise noted

. .