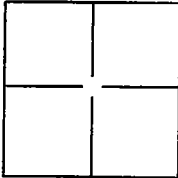


CORNER RECORD

Document Number CR-09-17

City of _____

County of SAN JOAQUIN, CaliforniaBrief Legal Description LOT 11, KLINE TRACT, 11 M & P 152**CORNER TYPE**

Government Corner ☐ Control ☐
Meander ☐ Property ☒
Rancho ☐ Other ☐

Date of Survey SEPT. 8, 2008**COORDINATES(Optional)**

N. _____
E. _____
Zone _____ NAD27 ☐ NAD83 ☐
NAD83 Epoch _____
Elev. _____
Vert. Datum: NGVD29 ☐ NADV88 ☐
Meas. Units: Metric ☐ Imperial ☐

Corner - Left as found ☐ Found and tagged ☐ Established ☐ Reestablished ☒ Rebuilt ☐

Identification and type of corner found: Evidence used to identify or procedure used to establish or reestablish the corner:

FOUND MONUMENTS ALONG THE NORTH LINE OF LOTS 10 THRU 14
OF SAID KLINE TRACT SUFFICIENT TO RE-ESTABLISH
THE NORTHWEST AND NORTHEAST CORNERS OF SAID LOT 11.
SEE SKETCH.

A description of the physical condition of the monument as found and as set or reset:

SET 3/4" REBAR W/PLASTIC CAP STAMPED L.S.3735

SURVEYOR'S STATEMENT

This Corner Record was prepared by me or under my direction in conformance with

the Land Surveyor's Act on


Signed

SEPT. 17, 2008
[Signature] P.L.S. or R.C.E. No.: L.S.3735**COUNTY SURVEYOR'S STATEMENT**This Corner Record was received JAN. 29TH 2009 and examinedand filed FEBRUARY 4 2009

Signed

John G. May P.L.S. or R.C.E. No.: 6186Title Deputy County Surveyor

County Surveyor's Comment _____

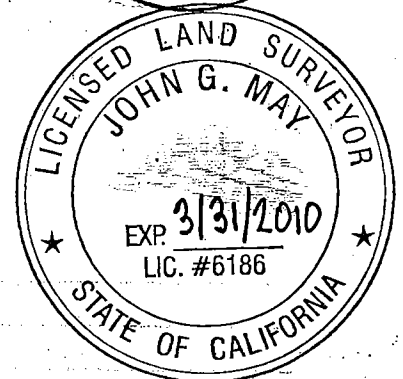

LEGEND

- SET 3/4" REBAR W/CAP L.S. 3735
- FOUND MONUMENT AS NOTED
- (1) 11-RM-152, KLINE TRACT
- (M) MEASURED ON THIS SURVEY
- M&P MAPS AND PLATS
- WESTERLY BOUNDARY LINE
PER KLINE TRACT 11-M&P-152

BASIS OF BEARINGS:

THE BASIS OF BEARINGS FOR THIS SURVEY IS IDENTICAL WITH THE SOUTHERLY RIGHT-OF-WAY LINE OF JOSEPH ROAD AS SHOWN ON THAT MAP FILED IN BOOK 11 OF MAPS AND PLATS AT PAGE 152 AS ESTABLISHED BETWEEN MONUMENTS FOUND THEREON, THE BEARING OF WHICH IS S89°58'45"E.

SCALE: 1"=40'

JOSEPH ROAD

