


CORNER RECORD

Document Number CR-09-37

City of \_\_\_\_\_

County of San Joaquin, California

Brief Legal Description EAST QUARTER CORNER OF SECTION 19

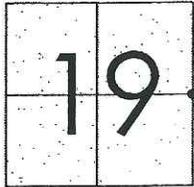

T3N R7E

CORNER TYPE

Government Corner  Control   
Meander  Property   
Rancho  Other   
Date of Survey Dec. 15, 2008

COORDINATES (Optional)

N. \_\_\_\_\_  
E. \_\_\_\_\_  
Zone \_\_\_\_\_ NAD27  NAD83   
NAD83 Epoch \_\_\_\_\_  
Elev. \_\_\_\_\_  
Vert. Datum: NGVD29  NAVD88   
Meas. Units: Metric  Imperial

Corner - Left as found  Found and tagged  Established  Reestablished  Rebuilt

Identification and type of corner found: Evidence used to identify or procedure used to establish or reestablish the corner:  
SEE SKETCH ON BACKSIDE.

A description of the physical condition of the monument as found and as set or reset:  
SEE SKETCH ON BACKSIDE.

SURVEYOR'S STATEMENT

This Corner Record was prepared by me or under my direction in conformance with the Land Surveyors' Act on February 17<sup>th</sup>, 2009.

Signed [Signature] P.L.S. Number 8470


COUNTY SURVEYOR'S STATEMENT

This Corner Record was received February 19, 2009 and examined and filed MARCH 10, 2009.

by Signed Thomas M. Gau R.C.E. No. 23341  
Title County Surveyor


County Surveyor's Comment \_\_\_\_\_

\_\_\_\_\_  
\_\_\_\_\_

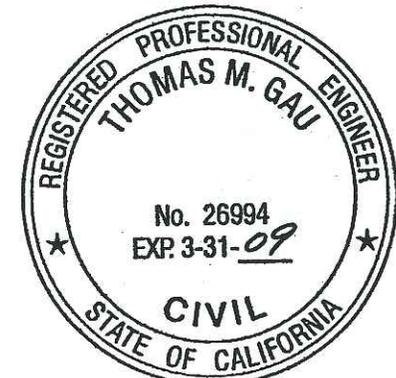



N.T.S.

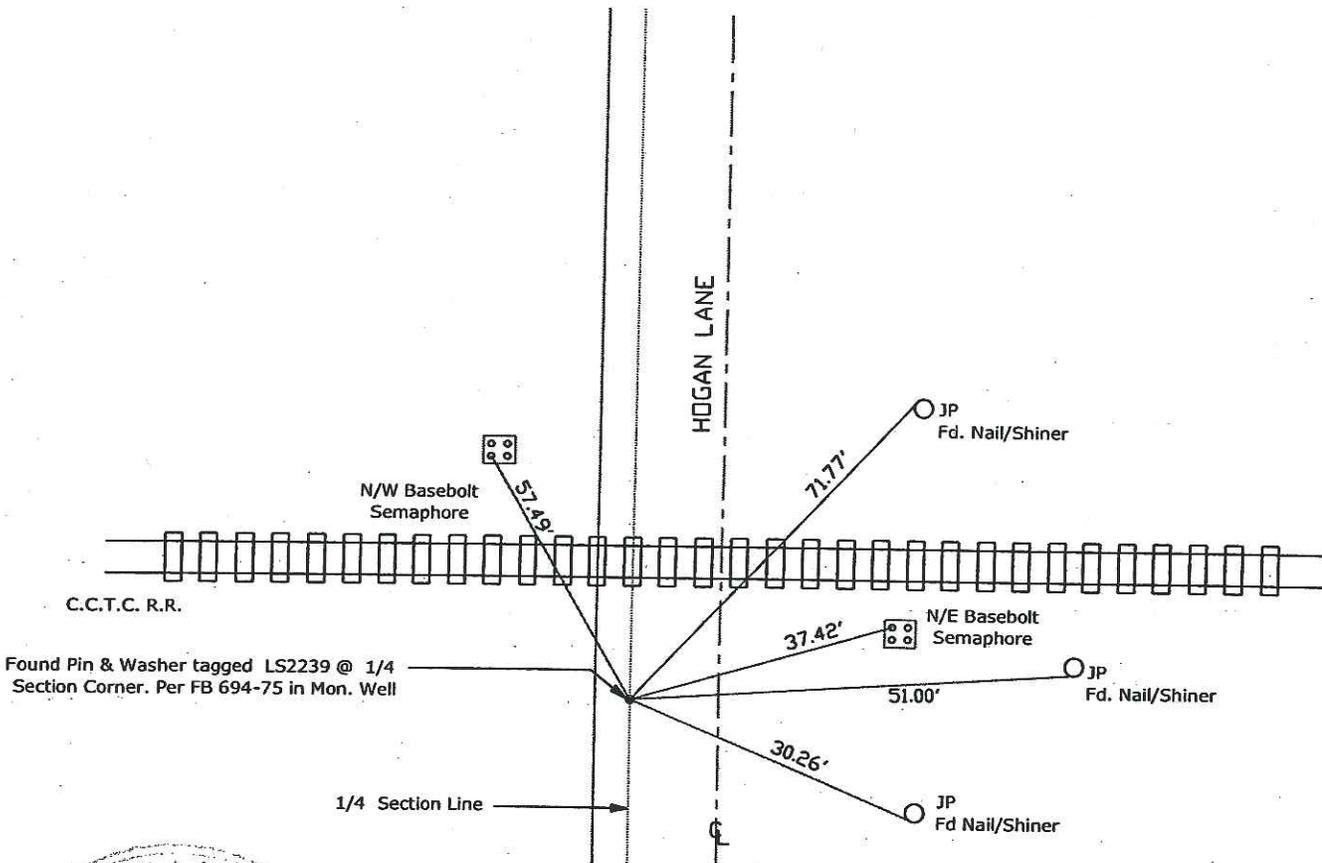

Note: Found Monuments are not tagged nor of Record, unless otherwise noted.

No Attempt Was Made to Verify the Monument(s)

NTS= Not to Scale

FP=Fence Post

CP=Cuy Post

JP=Joint Pole

PP=Power Pole

SP=Service Pole

TP=Telephone Pole

S.F.N=Searched Found Nothing

N.T.S.=Not To Scale

Set=Conc. Nail with Brass Washer Stamped

"S.J. Co." unless otherwise noted

