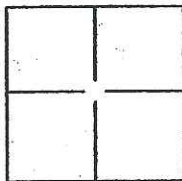


CORNER RECORD

Document Number CR-09-41City of County of San Joaquin, CaliforniaBrief Legal Description Parcel described on P.M. 9-127 being the Merger of parcels "B" & "1" on Said P.M**CORNER TYPE**


Government Corner	☐	Control	☐
Meander	☐	Property	☒
Rancho	☐	Other	☐

Date of Survey November 6, 2008**COORDINATES(Optional)**

N.
E.
Zone NAD27 ☐ NAD83 ☐
NAD83 Epoch
Elev.
Vert. Datum: NGVD29 ☐ NADV88 ☐
Meas. Units: Metric ☐ Imperial ☒

Corner - Left as found ☐ Found and tagged ☐ Established ☐ Reestablished ☒ Rebuilt ☐

Identification and type of corner found: Evidence used to identify or procedure used to establish or reestablish the corner:

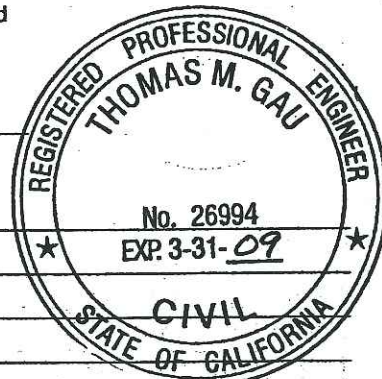See plat on backA description of the physical condition of the monument as found and as set or reset: Set 3/4" diameter rebar 30" long tagged "L.S. 8080"**SURVEYOR'S STATEMENT**This Corner Record was prepared by me or under my direction in conformance with the Land Surveyor's Act on March 3rd, 2009Signed P.



PLAT OF LOTS MERGED ON P.M. 9-127
S.J.C.R.