

CORNER RECORD


City of _____

Document Number CR-09-42
County of San Joaquin, California

Brief Legal Description APN: 059-140-33, Commonly known as 11052 North Micke Grove Road
Lodi, CA 95240

CORNER TYPE

COORDINATES (Optional)

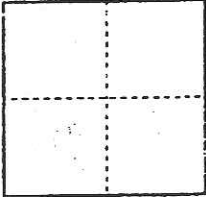

Government Corner ☐ Control ☐
Meander ☐ Property ☒
Rancho ☐ Other ☐

Date of Survey 3/17/09

N. _____
E. _____
Zone _____ NAD27 ☐ NAD83 ☐
NAD83 Epoch _____
Elev. _____
Vert. Datum: NGVD29 ☐ NAVD88 ☐
Meas. Units: Metric ☐ Imperial ☐

Corner - Left as found ☐ Found and tagged ☐ Established ☐ Reestablished ☒ Rebuilt ☐

Identification and type of corner found: Evidence used to identify or procedure used to establish or reestablish the corner:

The west line of Parcel "C" per Parcel map 11-54, San Joaquin County Records, was the
basis for this survey. The set monument was re-established per said map.

A description of the physical condition of the monument as found and as set or reset: Set 3/4" x 30"
iron rod capped LS 7269.

SURVEYOR'S STATEMENT

This Corner Record was prepared by me or under my direction in conformance with
the Land Surveyors' Act on April 10, 2009.


Signed Joe Murphy L.S. or R.C.E. Number LS 7269



COUNTY SURVEYOR'S STATEMENT

This Corner Record was received APRIL 10, 2009 and examined
and filed April 17, 2009.

Signed Thomas M. Gau
Title County Surveyor

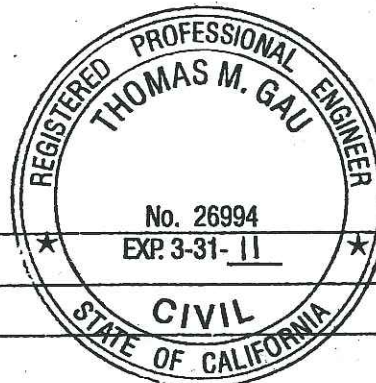

County Surveyor's Comment _____

MICKIE GROVE ROAD

EIGHT MILE ROAD

FD. 3/4" REBAR(R1)
NO TAG

513.11'
(R1)(M)

22'

W

N 00°07'30"

W

PARCEL C
P.M. 11-54

S 88°52'15" E 188.71'(R1)(M)

FD. 3/4" REBAR(R1)
NO TAG

SET 3/4" I.R.
CAPPED "LS 7269"

APN: 059-140-33

N 00°07'30" W 208.71'(R1)(M)

FD. 3/4" REBAR(R1)
NO TAG

SCALE: N 1" = 50'

LEGEND

P.M.	PARCEL MAP
FD.	FOUND
I.R.	IRON ROD
●	FOUND MONUMENT AS NOTED
○	SET MONUMENT AS NOTED
(R1)	P.M. 11-54
(M)	MEASURED