


# CORNER RECORD

Document Number CR-09-57  
County of San Joaquin, California

City of \_\_\_\_\_

Brief Legal Description ZEPHYR DRIVE 42' NORTH OF LINNE ROAD

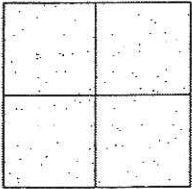

## CORNER TYPE

Government Corner ☐ Control ☐  
Meander ☐ Property ☐  
Rancho ☐ Other ☒

Date of Survey May 7, 2009

## COORDINATES (Optional)

N. \_\_\_\_\_  
E. \_\_\_\_\_  
Zone \_\_\_\_\_ NAD27 ☐ NAD83 ☐  
NAD83 Epoch \_\_\_\_\_  
Elev. \_\_\_\_\_  
Vert. Datum: NGVD29 ☐ NAVD88 ☐  
Meas. Units: Metric ☐ Imperial ☒

Corner - Left as found ☒ Found and tagged ☐ Established ☐ Reestablished ☐ Rebuilt ☐

Identification and type of corner found: Evidence used to identify or procedure used to establish or reestablish the corner:  
SEE SKETCH ON BACKSIDE.

A description of the physical condition of the monument as found and as set or reset:  
SEE SKETCH ON BACKSIDE.

## SURVEYOR'S STATEMENT

This Corner Record was prepared by me or under my direction in conformance with  
the Land Surveyors' Act on June 18, 2009.

Signed [Signature] P.L.S. Number 8470

## COUNTY SURVEYOR'S STATEMENT


This Corner Record was received JUNE 22, 2009 and examined  
and filed JULY 15, 2009.



For Title County Surveyor

County Surveyor's Comment \_\_\_\_\_

(D.D. Sheet No. 68 )  
(Job No. 230194)

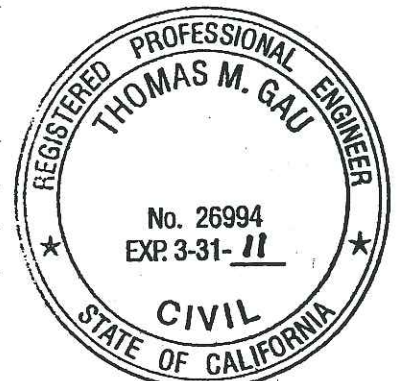

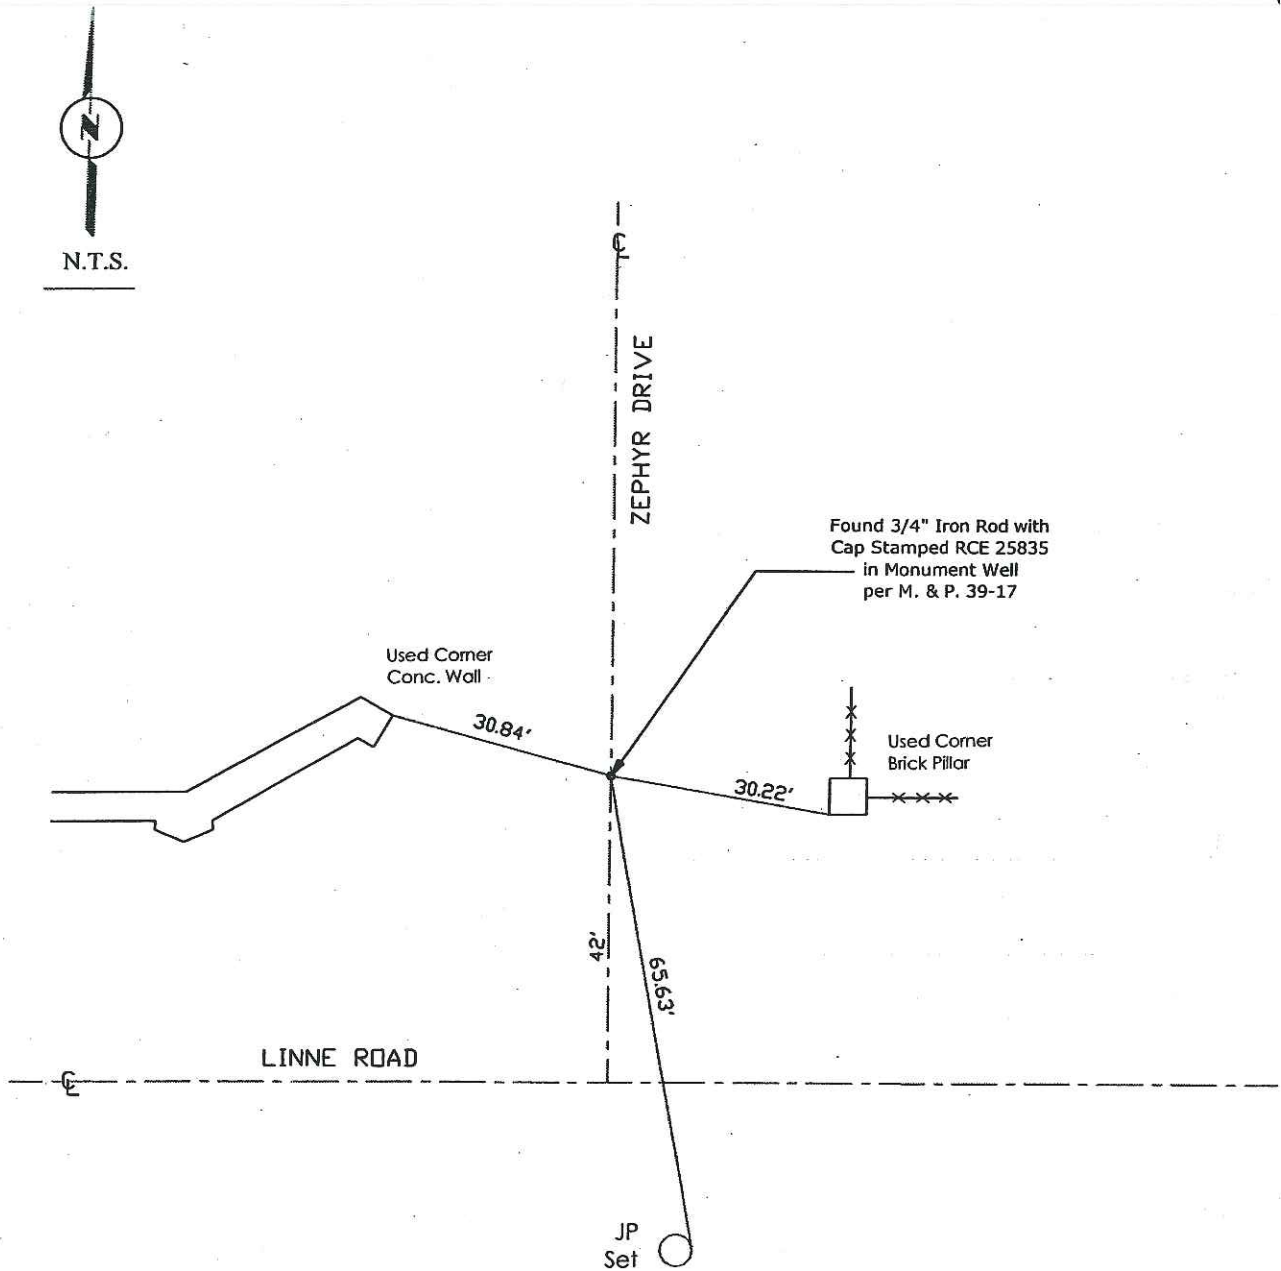

Note: Found Monuments are not tagged unless otherwise noted.

"No Attempt Was Made to Verify the Monument(s)"

FP=Fence Post  
 GP=Guy Post  
 JP=Joint Pole  
 LP=Lamp Pole  
 PP=Power Pole  
 RS=Record of Survey  
 SP=Service Pole  
 TP=Telephone Pole  
 SDI=Storm Drain Inlet  
 S.F.N=Searched Found Nothing  
 N.T.S.=Not To Scale  
 Set=Conc. Nail with Brass Washer Stamped  
 "S.J. Co." unless otherwise noted