


# CORNER RECORD

Document Number CR-09-67  
 City of \_\_\_\_\_ County of San Joaquin, California

Brief Legal Description SOUTHBOUND INTERSTATE FIVE ON RAMP @ MATHEWS ROAD

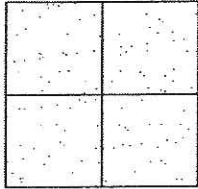

## CORNER TYPE

Government Corner ☐ Control ☐  
 Meander ☐ Property ☐  
 Rancho ☐ Other ☒

Date of Survey March 11, 2009

## COORDINATES (Optional)

N. \_\_\_\_\_  
 E. \_\_\_\_\_  
 Zone \_\_\_\_\_ NAD27 ☐ NAD83 ☐  
 NAD83 Epoch \_\_\_\_\_  
 Elev. \_\_\_\_\_  
 Vert. Datum: NGVD29 ☐ NAVD88 ☐  
 Meas. Units: Metric ☐ Imperial ☒

Corner - Left as found ☒ Found and tagged ☐ Established ☐ Reestablished ☐ Rebuilt ☐

Identification and type of corner found: Evidence used to identify or procedure used to establish or reestablish the corner:  
SEE SKETCH ON BACKSIDE.

A description of the physical condition of the monument as found and as set or reset:  
SEE SKETCH ON BACKSIDE.

## SURVEYOR'S STATEMENT

This Corner Record was prepared by me or under my direction in conformance with  
 the Land Surveyors' Act on June 18, 2009.

Signed Kevin L. Jorgensen P.L.S. Number 8470

## COUNTY SURVEYOR'S STATEMENT

This Corner Record was received June 22, 2009 and examined  
 and filed July 15, 2009.


Signed Thomas M. Gau R.C.E. No. 23341

**PR** Title County Surveyor

County Surveyor's Comment \_\_\_\_\_

(D.D. Sheet Nos. 34 )  
 (Job No. 220796)



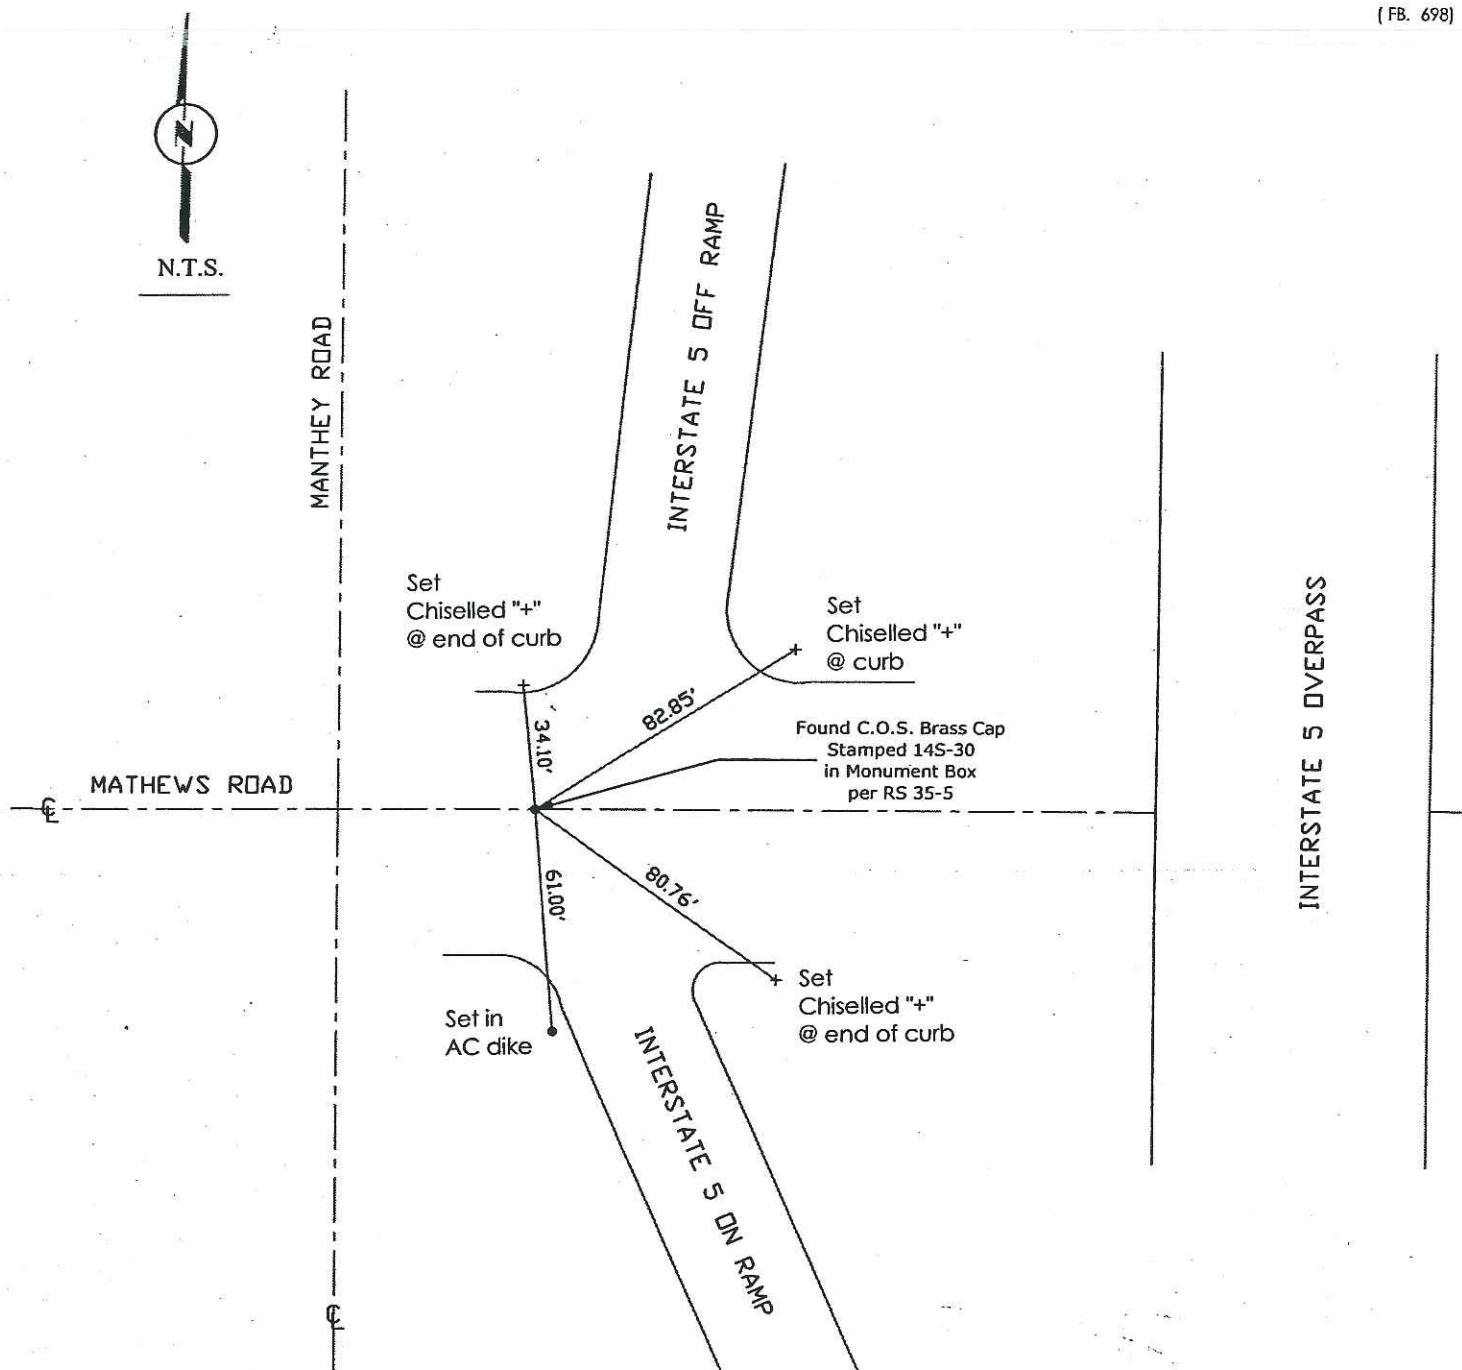

Note: Found Monuments are not tagged unless otherwise noted.

"No Attempt Was Made to Verify the Monument(s)"

FP=Fence Post  
 GP=Guy Post  
 JP=Joint Pole  
 LP=Lamp Pole  
 PP=Power Pole  
 RS=Record of Survey  
 SP=Service Pole  
 TP=Telephone Pole  
 SDI=Storm Drain Inlet  
 S.F.N=Searched Found Nothing  
 N.T.S.=Not To Scale  
 Set=Conc. Nail with Brass Washer Stamped  
 "S.J. Co." unless otherwise noted