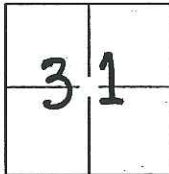


CORNER RECORD

Document Number CR-09-70City of Unincorporated Area of CountyCounty of San Joaquin, CaliforniaBrief Legal Description South half of Lot 9 per Book 6 of Maps and Plats, Page 10, S.J.C.R.

TIS, R9E

CORNER TYPE

Government Corner	<input type="checkbox"/>	Control	<input type="checkbox"/>
Meander	<input type="checkbox"/>	Property	<input checked="" type="checkbox"/>
Rancho	<input type="checkbox"/>	Other	<input type="checkbox"/>

Date of Survey April 22, 2009**COORDINATES(Optional)**

N. _____
E. _____
Zone _____ NAD27 ☐ NAD83 ☐
NAD83 Epoch _____
Elev. _____
Vert. Datum: NGVD29 ☐ NADV88 ☐
Meas. Units: Metric ☐ Imperial ☒

Corner - Left as found ☒ Found and tagged ☐ Established ☐ Reestablished ☐ Rebuilt ☐

Identification and type of corner found: Evidence used to identify or procedure used to establish or reestablish the corner:

SEE SKETCH ON PAGE 2


A description of the physical condition of the monument as found and as set or reset: _____

SEE SKETCH ON PAGE 2**SURVEYOR'S STATEMENT**

This Corner Record was prepared by me or under my direction in conformance with

the Land Surveyor's Act on June 17th, 2009.Signed [Signature] P.L.S. or R.C.E. No.: 7079**COUNTY SURVEYOR'S STATEMENT**This Corner Record was received JULY 16, 2009 and examinedand filed JULY 16, 2009.Signed Thomas M. Gau P.L.S. or R.C.E. No.: 23341FBR Title COUNTY SURVEYOR

County Surveyor's Comment _____

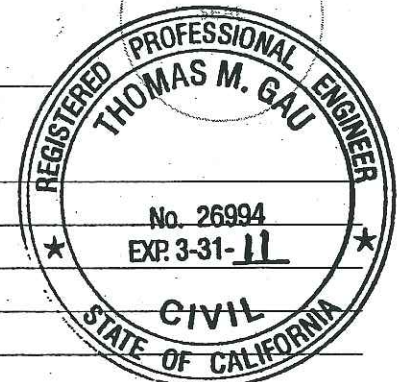



SCALE: 1"=100'

LOT 8
6-M&P-10

NORTH 1/2 LOT 9
6-M&P-10

SOUTH 1/2 LOT 9
6-M&P-10

LOT 10
6-M&P-10

FD 3/4" REBAR PER (C), NO TAG,
ON NORTH LINE OF SOUTH
1/2 OF LOT 9 PER (B) AT
RIGHT-OF-WAY LINE

WEST

WEST

FD 3/4" IP PER (B)(C), NO TAG
ON SOUTH LINE OF SOUTH 1/2 OF
LOT 9 AT RIGHT-OF-WAY LINE

FD 1" IP, NO TAG,
AT SW CORNER OF
LOT 12, 1" IPIN PER (C)

LAWRENCE
ROAD

20'

20'

LOT 3
6-M&P-10

S01'25'25"E
938.04'(M)
937.80'(B)

S01'16'30"E
155.94'(M)
155.93'(B)
0.24'(M)(C)

FD 3/4" IP
PER (B), NO TAG

FD 3/4" IP
PER (B)(C), NO TAG

1/4 SECTION LINE
PER (B)

FD 3/4" REBAR
PER (C), NO TAG

678.44'(M)(B) 678.11'(C)

678.04'(M)(B)

REFERENCES:

- (A) 6-M&P-10, S.J.C.R.
- (B) 19-RS-38, S.J.C.R.
- (C) 22-RS-134, S.J.C.R.

LEGEND:

- FD FOUND
- IP IRON PIPE
- RS- RECORD OF SURVEY, BOOK, PAGE, S.J.C.R.
- M&P- MAPS & PLATS, BOOK, PAGE, S.J.C.R.
- S.J.C.R. SAN JOAQUIN COUNTY RECORDS