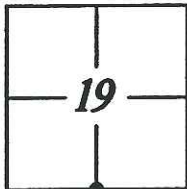


# CORNER RECORD

Document Number

CR-09-84

City of RIPONCounty of SAN JOAQUIN, CaliforniaBrief Legal Description SOUTH 1/4 CORNER SECTION 19, T.2S., R.8E., M.D.B.&M.

T2S, R8E

## CORNER TYPE

Government Corner ☒ Control ☐  
Meander ☐ Property ☐  
Rancho ☐ Other ☐

Date of Survey NOVEMBER 5, 2009

## COORDINATES (Optional)

N 2092327.65E 6378603.29Zone 3 NAD27 ☐ NAD83 ☒NAD83 Epoch 2004.9147-2005.0900Elev. 62.47Vert. Datum: NVGD29 ☐ NVGD88 ☒Meas. Units: Metric ☐ Imperial ☒Corner— Left as found ☐ Found and tagged ☐ Established ☐ Reestablished ☐ Rebuilt ☒

Identification and type of corner found: Evidence used to identify or procedure used to establish or reestablish the corner:

BRASS DISK IN MONUMENT WELL AT THE SOUTH 1/4 CORNER OF SECTION 19, T.2S., R.8E.,M.D.B.&M. AT THE INTERSECTION OF VERA AVENUE AND W. MAIN STREET WAS DESTROYED DURINGCONSTRUCTION OF W. MAIN STREET. USED FOUND EXISTING MONUMENTS (AS SHOWN ON DIAGRAMPAGE 2) REFERENCED AND SHOWN ON BOOK 23 OF PARCEL MAPS, AT PAGE 51, SAN JOAQUINCOUNTY RECORDS.

A description of the physical condition of the monument as found and as set or reset:

SET 2 1/2" BRASS DISK IN MONUMENT WELL (SEE CITY OF RIPON STANDARD DRAWING M-2)COORDINATES AND ELEVATION SHOWN WERE DERIVED USING G.P.S. STATIC OBSERVATIONS AND RESOLVEDUSING TOPCON TOOLS VERSION 1.20 HOLDING CITY OF RIPON CONTROL MONUMENTS 6016, 6021 AND 6024 ASSHOWN ON MAP FILED IN BOOK 35 OF SURVEYS, AT PAGE 196, S.J.C.R. AS "FIXED".

## SURVEYOR'S STATEMENT


This Corner Record was prepared by me or under my direction in conformance with


the Land Surveyors' Act on December 3, 2009.Signed Natasha P.L.S. or R.C.E. Number 6953

## COUNTY SURVEYOR'S STATEMENT


County Surveyor's Comment \_\_\_\_\_

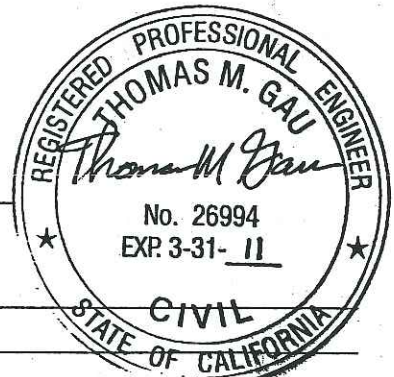

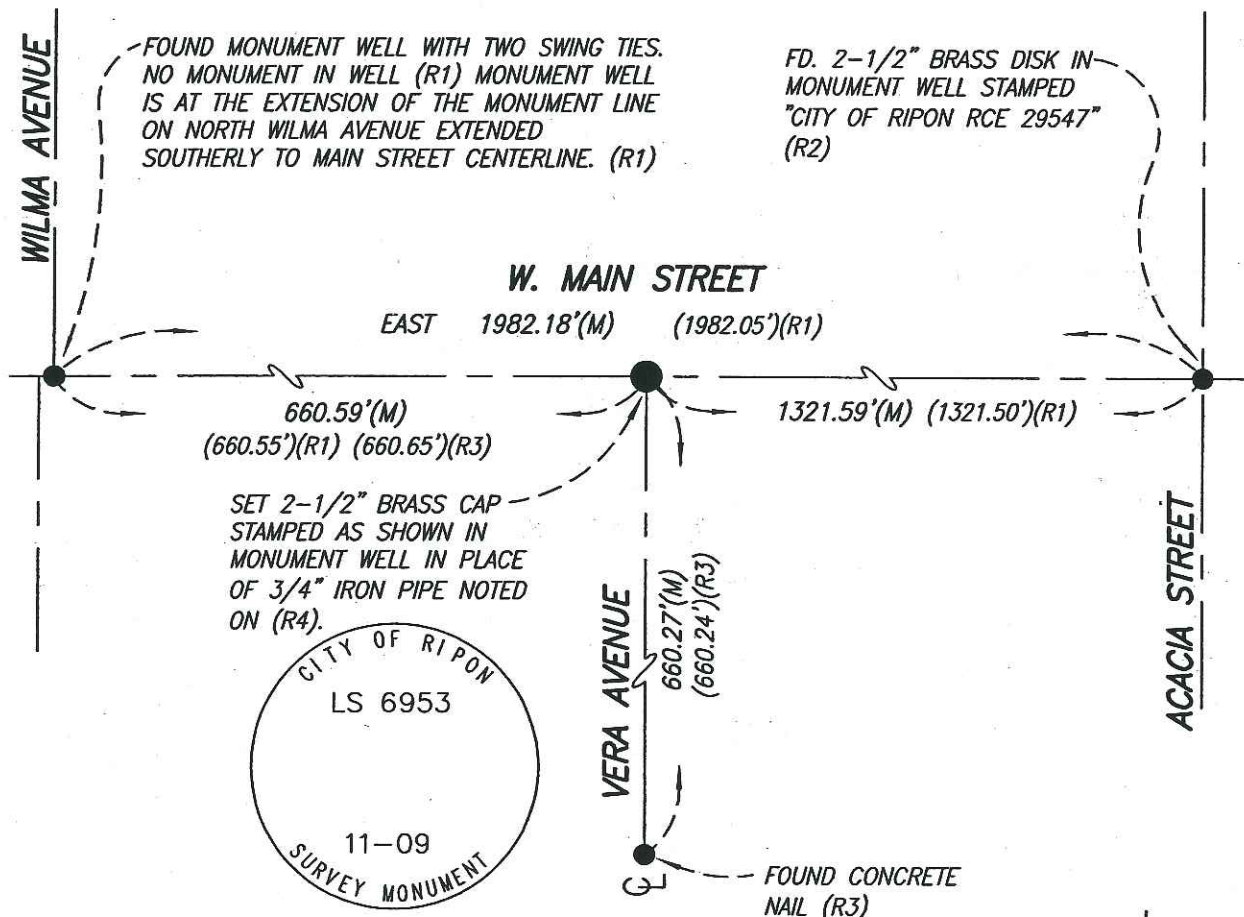

### LEGEND:

- SET MONUMENT AS NOTED
- FOUND MONUMENT AS NOTED
- S.J.C.R. DENOTES SAN JOAQUIN COUNTY RECORDS
- C.R. CORNER RECORD
- P.M. DENOTES PARCEL MAP, BOOK-PAGE, S.J.C.R.
- R.S. DENOTES RECORD OF SURVEY, BOOK-PAGE, S.J.C.R.

### REFERENCES:

- (R1) PM. 23-51, S.J.C.R.
- (R2) C.R.-95-022
- (R3) RS. 33-46, S.J.C.R.
- (R4) C.R.-09-77

NOT TO SCALE