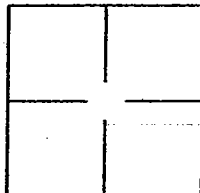


CORNER RECORD

Document Number CR-10-02City of TRACYCounty of SAN JOAQUIN

California

Brief Legal Description SOUTHWEST CORNER OF PARCEL "B", 10 PARCEL MAPS 150**CORNER TYPE**Government Corner ☐Meander ☐Rancho ☐Control ☐Property ☒Other ☐Date of Survey OCTOBER 2, 2009**COORDINATES (Optional)**

N

E

Zone

NAD27 ☐NAD83 ☐

NAD83 Epoch

Elev

Vert. Datum:

NGVD29 ☐NADV88 ☐

Meas Units:

Metric ☐Imperial ☒**Corner -**Left as found ☐Found and tagged ☐Established ☐Reestablished ☒Rebuilt ☐

Identification and type of corner found: Evidence used to identify or procedure used to establish or reestablish the corner:

SEE SKETCH ON PAGE 2 OF 2


A description of the physical condition of the monument as found and as set or reset:

SEE SKETCH ON PAGE 2 OF 2**SURVEYOR'S STATEMENT**

This Corner Record was prepared by me or under my direction in conformance with

the Land Surveyors' Act on OCTOBER 16, 2009.

Signed

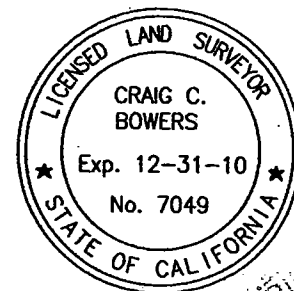P.L.S. Number 7049**COUNTY SURVEYOR'S STATEMENT**This Corner Record was received JANUARY 5, 2010 and examinedand filed January 19, 2010.


Signed

P.L.S. or R.C.E. Number 23341

Title

COUNTY SURVEYOR


County Surveyor's Comment

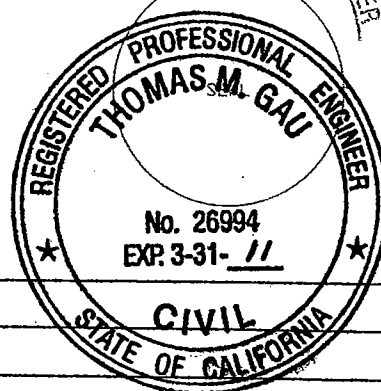

EAST LINE SECTION 30, T3S, R6E, M.D.B.&M.

BEVIS ROAD

FD SAN JOAQUIN COUNTY
2" BRASS DISK
MONUMENT IN
MONUMENT BOX AT EAST
1/4 SECTION CORNER
PER (R1)

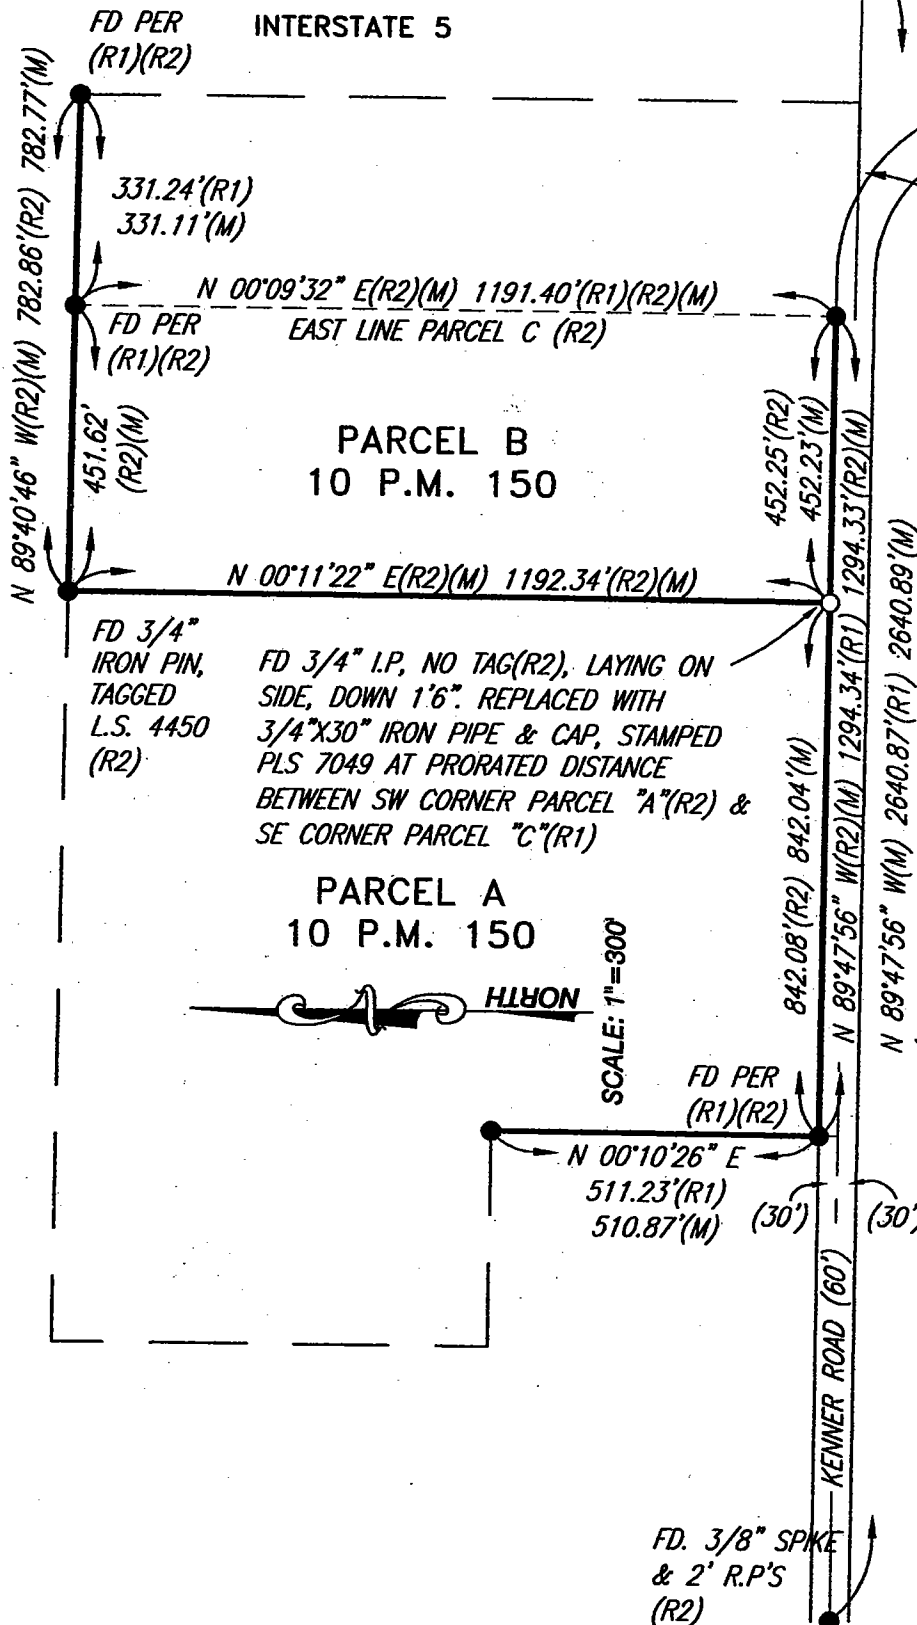

1/4 SECTION LINE, N.E.
1/4 SECTION 30, T3S,
R6E, M.D.B.&M.

LEGEND

- (R1)= 7 PARCEL MAPS 3
(R2)= 10 PARCEL MAPS 150
M = MEASURED
SJCR = SAN JOAQUIN COUNTY RECORDS
● = FOUND 3/4" IRON PIPE, TAGGED R.C.E. 14901, PER (R1), UNLESS NOTED OTHERWISE

ALL REFERENCES ARE TO
SAN JOAQUIN COUNTY
RECORDS