


CORNER RECORD

City of Unincorporated

Document Number 10-03

County of San Joaquin, California

Brief Legal Description Lot 15, Tract No. 130, Book. of Maps & Plats, Vol. 11, Page 134, S.J.Co. Records

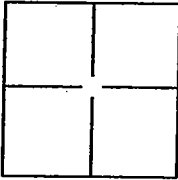

CORNER TYPE

Government Corner ☐ Control ☐
Meander ☐ Property ☒
Rancho ☐ Other ☐

Date of Survey October 20, 2009

COORDINATES(Optional)

N. _____

E. _____

Zone _____ NAD27 ☐ NAD83 ☐

NAD83 Epoch _____

Elev. _____

Vert. Datum: NGVD29 ☐ NADV88 ☐

Meas. Units: Metric ☐ Imperial ☐

Corner - Left as found ☐ Found and tagged ☐ Established ☐ Reestablished ☒ Rebuilt ☐

Identification and type of corner found: Evidence used to identify or procedure used to establish or reestablish the corner:

Found two original tract monuments for Tract No. 130, Book. of Maps & Plats, Vol. 11, Page 134, and found
two original iron pipe monuments at the subject lot corners, re-established the remaining two lot corners at
the owners request

A description of the physical condition of the monument as found and as set or reset: Found two 4"d. iron pipe monuments
with copper plates and pins at two of the tract corners as shown, and found two 1" d. iron pipe monuments,
with no tags remaining, at two of the lot corners. re-established the other two corners with a 5/8"d. x 24"
rebar and aluminum cap stamped "Lamb Surveying, Inc, LS 6627"

SURVEYOR'S STATEMENT

This Corner Record was prepared by me or under my direction in conformance with

the Land Surveyor's Act on November 22, 2009

Signed Gary K. Lamb P.L.S. or R.C.E. No.: 6627




COUNTY SURVEYOR'S STATEMENT

This Corner Record was received JANUARY 25, 2010 and examined

and filed FEBRUARY 1, 2010

Signed Thomas M. Gau P.L.S. or R.C.E. No.: 26994

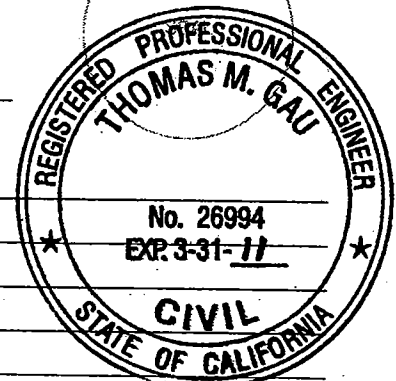

for Title COUNTY SURVEYOR

County Surveyor's Comment _____

ABBREVIATIONS
 FND = FOUND
 IP = IRON PIPE
 MON = MONUMENT
 R&C = REBAR & CAP

LEGEND

- ⊙ = FND 4"d. IP & DISK MON
- = FND 1"d. IP (OPEN)
- = SET 5/8 "d. REBAR & CAP "LS 6627"

