


CORNER RECORD

Document Number 10-27
City of Stockton County of San Joaquin County, California
Brief Legal Description Lot 10 in Block 50 East of Center Street

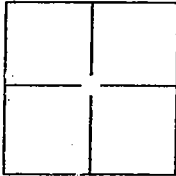

C.M. WEBER GRANT

CORNER TYPE

Government Corner ☐ Control ☐
Meander ☐ Property ☒
Rancho ☐ Other ☐

Date of Survey February 9, 2010

COORDINATES(Optional)

N. _____
E. _____
Zone _____ NAD27 ☐ NAD83 ☐
NAD83 Epoch _____
Elev. _____
Vert. Datum: NGVD29 ☐ NADV88 ☐
Meas. Units: Metric ☐ Imperial ☐

Corner - Left as found ☐ Found and tagged ☐ Established ☐ Reestablished ☒ Rebuilt ☐

Identification and type of corner found: Evidence used to identify or procedure used to establish or reestablish the corner:


Found and used chiseled crosses from Charles H. Widdows' field notes, Field Book 459, Page 62 and
CHW Plats 4534 & 4535 filed with the County Surveyor's Office.

A description of the physical condition of the monument as found and as set or reset: set - 3/4" x 30" Iron Pin,
tagged LS 5443

SURVEYOR'S STATEMENT

This Corner Record was prepared by me or under my direction in conformance with
the Land Surveyor's Act on March 26, 2010.

Signed David Lee Harris P.L.S. or R.C.E. No.: PLS 5443

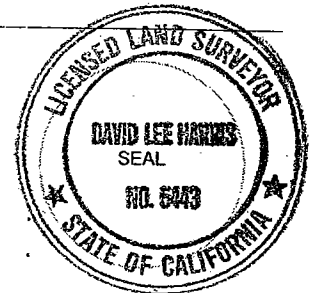


COUNTY SURVEYOR'S STATEMENT


This Corner Record was received MARCH 31, 2010 and examined
and filed APRIL 8, 2010.


Title COUNTY SURVEYOR

County Surveyor's Comment _____

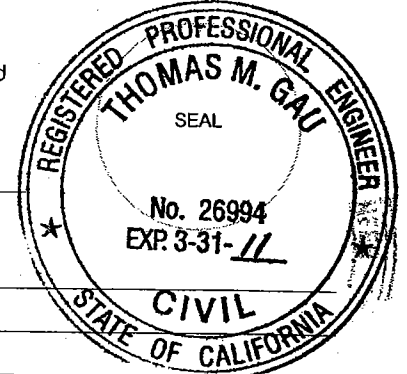

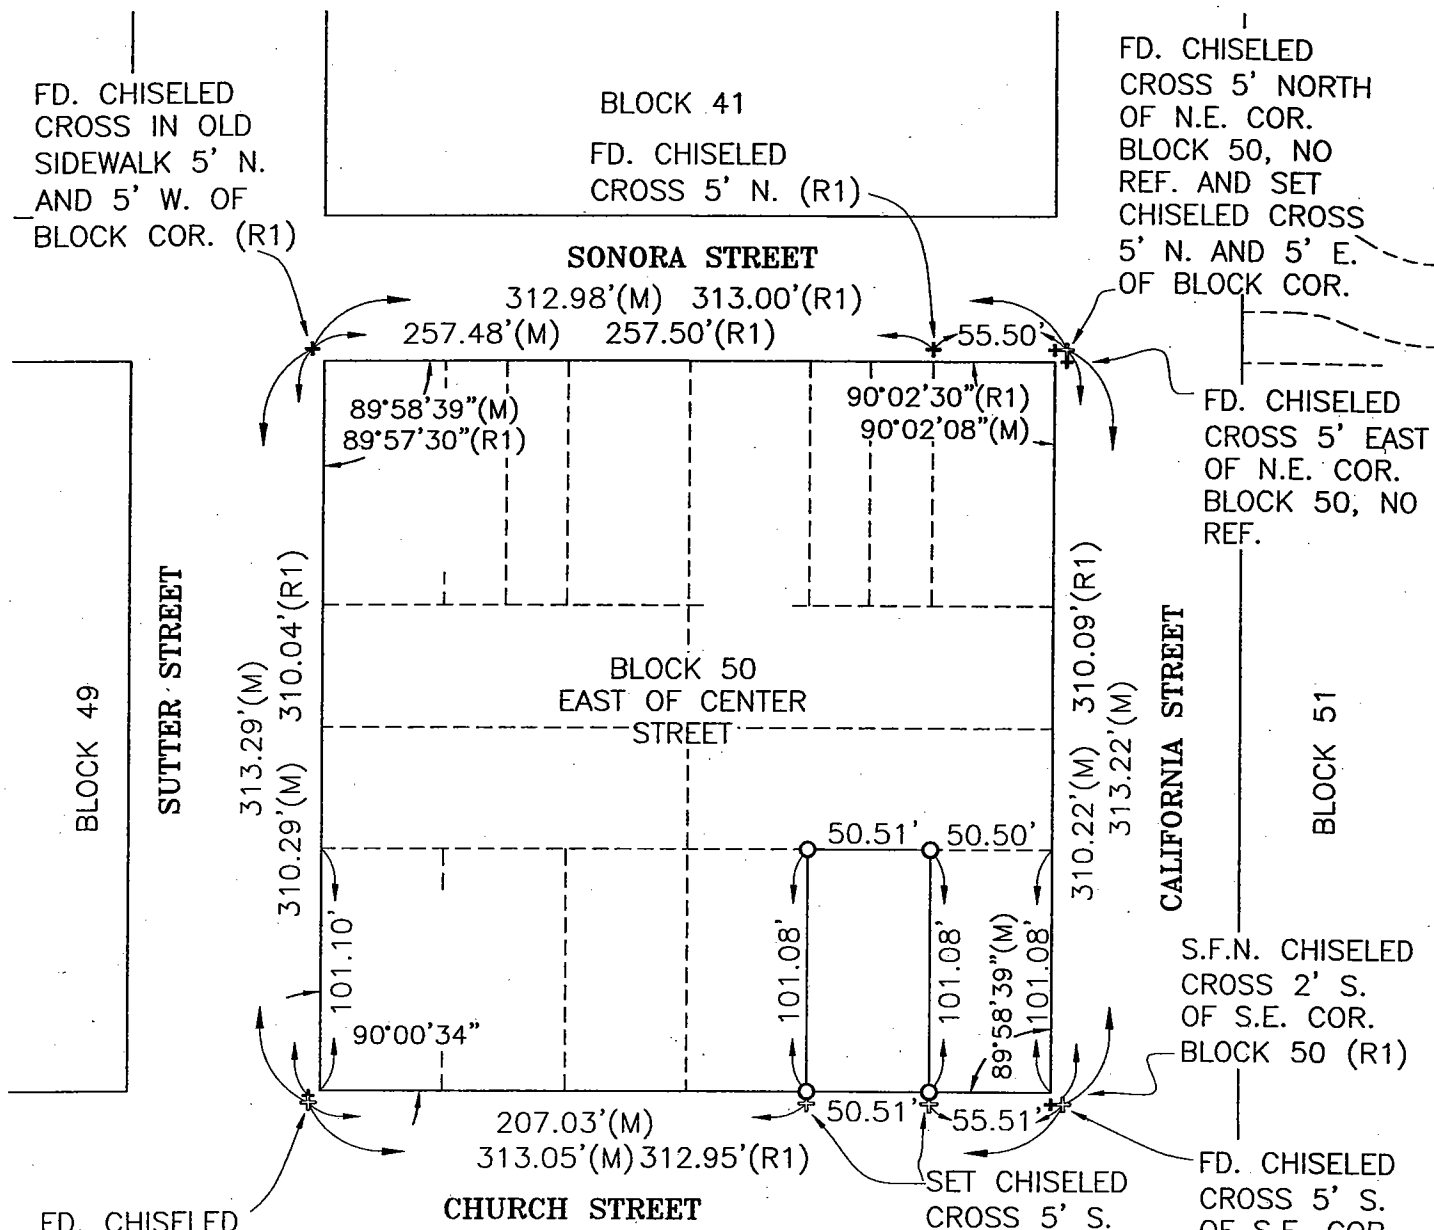

REFERENCES AND LEGEND:

- (R1) CHW FIELD BOOK 459 PAGE 62, AND PLATS 4534 & 4535
- SET 3/4" X 30" IRON PIN TAGGED L.S. 5443
- + CHISELED CROSS FOUND
- ⊕ CHISELED CROSS SET
- (M) MEASURED
- FD. FOUND
- S.F.N. SEARCHED FOUND NOTHING

ASPEN SURVEY
 COMPANY, INC.
 1121 OAKDALE RD., STE. 6 MODESTO, CA 95355
 PH: (209) 526-9724 PH: (800) 526-9724
 FX: (209) 526-0472



1"=80'