


# CORNER RECORD

Document Number 10-30

City of Escalon

County of San Joaquin, California

Brief Legal Description Lots 7, 8 and 9 in Block 1, Jackson Addition to Escalon 8-Maps & Plats-29

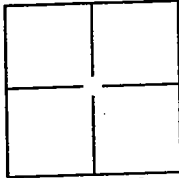

T.Z.S., R.9E.

## CORNER TYPE

Government Corner ☐ Control ☐  
Meander ☐ Property ☒  
Rancho ☐ Other ☐

Date of Survey January 28, 2010

## COORDINATES(Optional)

N. \_\_\_\_\_  
E. \_\_\_\_\_  
Zone \_\_\_\_\_ NAD27 ☐ NAD83 ☐  
NAD83 Epoch \_\_\_\_\_  
Elev. \_\_\_\_\_  
Vert. Datum: NGVD29 ☐ NADV88 ☐  
Meas. Units: Metric ☐ Imperial ☒

Corner - Left as found ☐ Found and tagged ☐ Established ☐ Reestablished ☒ Rebuilt ☐


Identification and type of corner found: Evidence used to identify or procedure used to establish or reestablish the corner:  
No original lot corners were found from the Jackson Addition to Escalon. Positions shown were reestablished  
using found monuments of record and other evidence as shown.

A description of the physical condition of the monument as found and as set or reset: set - 3/4" x 30" Iron Pin,  
tagged LS 5443

## SURVEYOR'S STATEMENT

This Corner Record was prepared by me or under my direction in conformance with  
the Land Surveyor's Act on April 19, 2010.

Signed [Signature] P.L.S. or R.C.E. No.: 5443

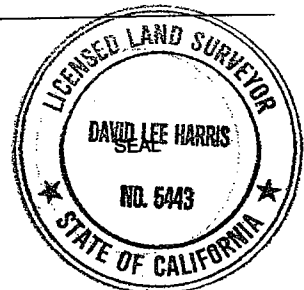

## COUNTY SURVEYOR'S STATEMENT

This Corner Record was received APRIL 21, 2010 and examined

and filed April 27, 2010

Signed [Signature] P.L.S. or R.C.E. No.: 23341

FOR Title COUNTY SURVEYOR

County Surveyor's Comment \_\_\_\_\_

