
CORNER RECORD	<b>J</b>		Document N	wullibel		<u>3</u> 乙
City ofManteca			County of	San d	Joaquin	, Californ
Brief Legal Description Proj	<u>perty line pr</u>	ojections	of Lot	120 (2	28 M&P 17	)
	CORI	NER TYPE		COO	RDINATES (C	Optional)
	Government Corner	☐ Contro	и 🗀 .	ţ		
<del></del>	Meander	☐ Prope	rhy 177	Zone	NAD27 ch	
	Rancho	☐ Other		Elev		
	Date of SurveyA	pril 8, 2	/ I I I I I I	Vert. Datum: Meas. Units:	NGVD29 ☐ Metric ☐	NAVD88 □ Imperial □
Corner – Left as found	d □ Found and ta	gged 🗆 Es	stablished 🗗	Reesta	blished 🏻	Rebuilt 🛘
Identification and type of corner	found: Evidence used	to identify or pr	ocedure used	to establis	h or reestablish	the corner:
Found Street Monum	ments as shown	n per 28	M&P 17.	All v	vere in r	elative
record positions.	Used to esta	ablish th	e prope	ty lir	nes of Lo	t 120 and
their Westerly pro	ojections. A	lso found	non-rec	cord cu	it crosse	s on
property line pro	ojections of I	Lot 120.				
				<del> </del>	· · · · · · · · · · · · · · · · · · ·	
A description of the physical con monument wells we						
monument wells we	re in good co	ndition.	Set Na	ils & 1		
SU This Corner Record was prepare the Land Surveyor's Act on Signed	re in good co	NT  Outside the second in the	Set Na	ils & l		s were new.

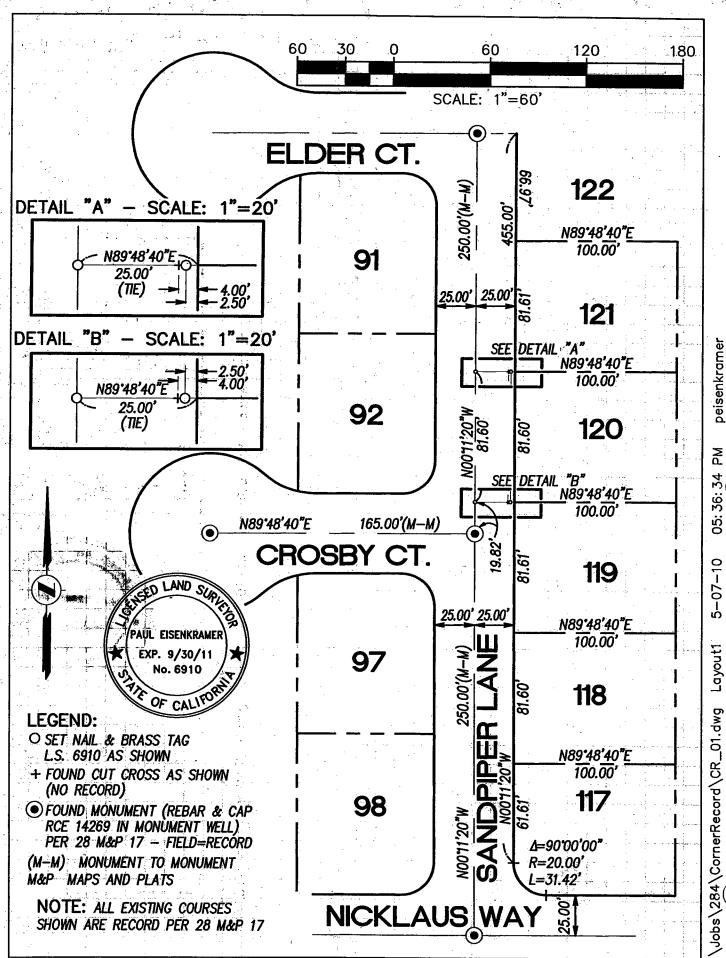

05: 5-07-10 Layout1 F: \Jobs\284\CornerRecord\CR\_01.dwg