


# CORNER RECORD

City of STOCKTON

Document Number 10-43

County of SAN JOAQUIN, California

Brief Legal Description IN SECTION 48, C.M. WEBER GRANT

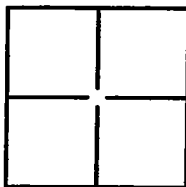

## CORNER TYPE

Government Corner ☐ Control ☒  
Meander ☐ Property ☐  
Rancho ☐ Other ☒

Date of Survey JUNE 7, 2010

## COORDINATES (Optional)

N \_\_\_\_\_  
E \_\_\_\_\_  
Zone \_\_\_\_\_ NAD27 ☐ NAD83 ☐  
NAD83 Epoch \_\_\_\_\_  
Elev. \_\_\_\_\_  
Vert. Datum: NVGD29 ☐ NVGD88 ☐  
Meas. Units: Metric ☐ Imperial ☐

Corner— Left as found ☒ Found and tagged ☐ Established ☐ Reestablished ☐ Rebuilt ☐

Identification and type of corner found: Evidence used to identify or procedure used to establish or reestablish the corner:

CENTERLINE MONUMENT ARCH-AIRPORT ROAD - CITY OF STOCKTON MONUMENT # 128 (3-S-7)  
MONUMENT IDENTIFIED AS BEING IN AREA OF RE-CONSTRUCTION.

SET HORIZONTAL TIES AS SHOWN ON PAGE 2.

MONUMENT DESTROYED PRIOR TO SETTING VERTICAL TIES.

A description of the physical condition of the monument as found and as set or reset: \_\_\_\_\_

SEE PAGE 2

## SURVEYOR'S STATEMENT

This Corner Record was prepared by me or under my direction in conformance with  
the Land Surveyors' Act on JUNE 25, 2010,

Signed [Signature] P.L.S. or R.C.E. Number 6406




## COUNTY SURVEYOR'S STATEMENT

This Corner Record was received AUGUST 9, 2010 and examined  
and filed August 10, 2010

Signed Thomas M. Gau P.L.S. or R.C.E. No. 23341

Title COUNTY SURVEYOR

County Surveyor's Comment \_\_\_\_\_

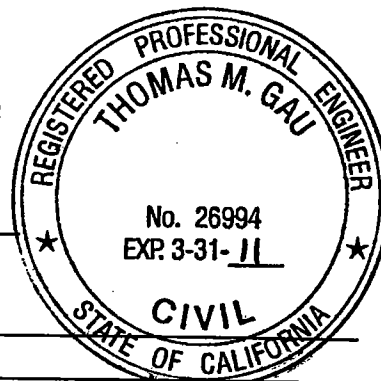

**LEGEND:**

- FOUND MONUMENT AS NOTED.
- SET 1/2" IRON PIPE WITH CAP L.S. 6406
- ⊗— SET PK NAIL AS NOTED.
- R.S. RECORD OF SURVEY, BOOK-PAGE, S.J.C.R.
- P.M. PARCEL MAPS, BOOK-PAGE, S.J.C.R.
- M.&P. MAPS AND PLATS, BOOK-PAGE, S.J.C.R.
- S.J.C.R. SAN JOAQUIN COUNTY RECORDS

