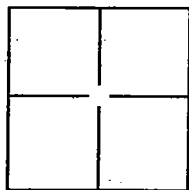


CORNER RECORD

Document Number CK-10-57City of LATHROPCounty of SAN JOAQUIN, CaliforniaBrief Legal Description SE 1/4 OF SECTION 27, T. 1 S., R. 6 E., M.D.B. & M.

CORNER TYPE

Government Corner ☐ Control ☐
Meander ☐ Property ☐
Rancho ☐ Other ☒

Date of Survey 04/29/10

COORDINATES(Optional)

N. _____
E. _____
Zone _____ NAD27 ☐ NAD83 ☐
NAD83 Epoch _____
Elev. _____
Vert. Datum: NGVD29 ☐ NADV88 ☐
Meas. Units: Metric ☐ Imperial ☐

Corner - Left as found ☒ Found and tagged ☐ Established ☐ Reestablished ☐ Rebuilt ☐

Identification and type of corner found: Evidence used to identify or procedure used to establish or reestablish the corner.

FOUND 3/4" IRON PIPE IN MONUMENT WELL, NO TAG, AT THE CENTERLINE INTERSECTION
OF HARLAN ROAD & NEW HARLAN ROAD. SET 3 MAG. NAILS w/TAG LS 6946 FOR TIES.

A description of the physical condition of the monument as found and as set or reset: _____

SURVEYOR'S STATEMENT

This Corner Record was prepared by me or under my direction in conformance with
the Land Surveyor's Act on September 15, 2010.


Signed R. GreenewaldP.L.S. or R.C.E. No.: 6946


COUNTY SURVEYOR'S STATEMENT

This Corner Record was received SEPTEMBER 16, 2010 and examined
and filed OCTOBER 7, 2010.


County Surveyor's Comment _____

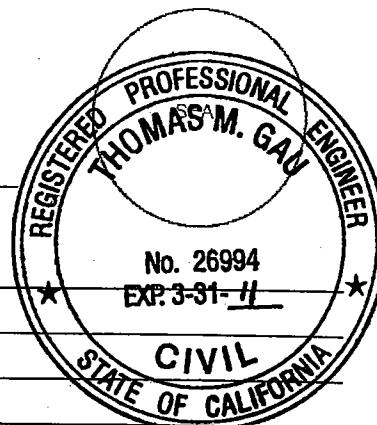

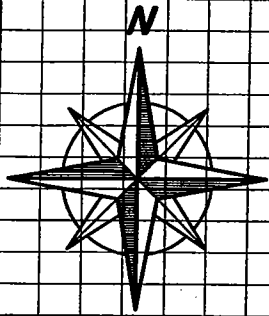

NOT TO SCALE

HARLAN ROAD

NEW HARLAN ROAD

Set Magnetic Nail w/Tag
LS 6946 in center of
sidewalk $\pm 100'$ North of
curb return

Set Magnetic Nail
w/Tag LS 6946 North
of Catch Basin

132.74°

131.85°

91.56°

Set Magnetic Nail
w/Tag LS 6946 in
center of sidewalk
at curb return