CORNER RECORD Document Number _ CR-10-67 County of San Joaquin, California Brief Legal Description HANSEN ROAD 1 MILE NORTH OF SCHULTE ROAD **CORNER TYPE** COORDINATES (Optional) Control Zone__ NAD27 ☐ NAD83 ☐ Meander Property □ NAD83 Epoch_ Rancho Other Elev. Vert. Datum: NGVD29 □ Date of Survey ____August 30, 2010 Meas, Units: Metric Imperial 🛛 **72**S R4E Corner -Left as found ☐ Found and tagged ☐ Established ☐ Reestablished Rebuilt 🖂 Identification and type of corner found: Evidence used to identify or procedure used to establish or reestablish the corner: SEE SKETCH ON BACKSIDE. A description of the physical condition of the monument as found and as set or reset: SEE SKETCH ON BACKSIDE. SURVEYOR'S STATEMENT This Corner Record was prepared by me or under my direction in conformance with the Land Surveyors' Act on October 28, 2010. P.L.S. Number <u>8470</u> No. 8470 COUNTY SURVEYOR'S STATEMENT This Corner Record was received OCTOBEL 28, 2010 and examined

Title County Surveyor

and filed NOVEMBER 1


County Surveyor's Comment_____

Tau _____ R.C.E. No. <u>23341</u>

(D.D. Sheet No. 52) Job No. 220009



N.T.S.

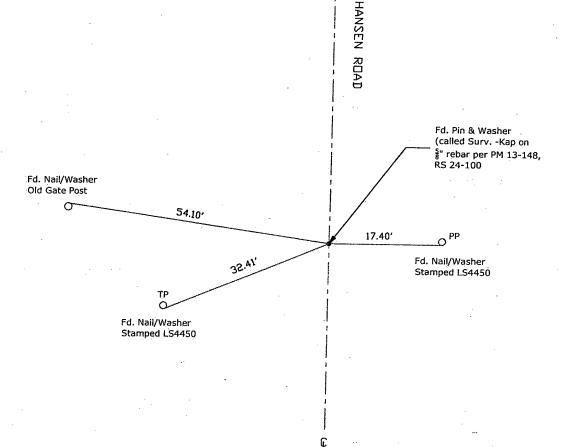

Note: Found Monuments are not tagged unless otherwise noted.

"No Attempt Was Made to Verify the Monument(s)"

Set=Conc. Nail with Brass Washer Stamped
"S.J. Co.", unless otherwise noted
Fd.=Found Conc. Nail with Brass Washer Stamped
"S.J. Co.", unless otherwise noted
FP=Fence Post
JP=Joint Pole
LP=Light Pole
PP=Power Pole
GP=Guy Pole
SP=Service Pole
TP=Telephone Pole
S.F.N.=Searched Found Nothing
N.T.S.=Not To Scale
M&P=Maps & Plats
PM=Parcel Map
RS=Record of Survey
FB=Field Book

HOVEMBER 1 Have