


CORNER RECORD

City of STOCKTON

Document Number CR-10-74
County of SAN JOAQUIN, California

Brief Legal Description IN SECTION 36, C.M. WEBER GRANT

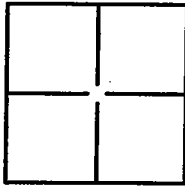

CORNER TYPE

Government Corner ☐ Control ☐
Meander ☐ Property ☐
Rancho ☐ Other ☒

Date of Survey AUGUST 16, 2010

COORDINATES (Optional)

N _____
E _____
Zone _____ NAD27 ☐ NAD83 ☐
NAD83 Epoch _____
Elev. _____
Vert. Datum: NVGD29 ☐ NVGD88 ☐
Meas. Units: Metric ☐ Imperial ☐

Corner— Left as found ☐ Found and tagged ☐ Established ☐ Reestablished ☒ Rebuilt ☐

Identification and type of corner found: Evidence used to identify or procedure used to establish or reestablish the corner:
CENTERLINE MONUMENT NORTH SIDE ARCH-AIRPORT ROAD AT "B" STREET.
MONUMENT DESTROYED DURING RE-CONSTRUCTION.
RESET FROM TIES AS SHOWN ON PAGE 2.

A description of the physical condition of the monument as found and as set or reset:
SEE PAGE 2

SURVEYOR'S STATEMENT

This Corner Record was prepared by me or under my direction in conformance with
the Land Surveyors' Act on OCTOBER 11, 2010,

Signed [Signature] P.L.S. or R.C.E. Number 6406




COUNTY SURVEYOR'S STATEMENT

This Corner Record was received OCTOBER 12, 2010 and examined
and filed NOVEMBER 1, 2010

Signed [Signature] P.L.S. or R.C.E. No: 23341

for Title COUNTY SURVEYOR

County Surveyor's Comment _____

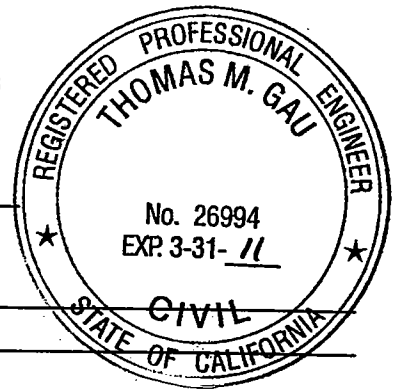

LEGEND:

- | | |
|----------|---|
| —○— | SET MONUMENT AS NOTED. |
| —●— | FOUND 1/2" IRON PIPE WITH CAP L.S. 6406, C.R. 10-41 |
| —✱— | FOUND PK NAIL AS NOTED. |
| R.S. | RECORD OF SURVEY, BOOK-PAGE, S.J.C.R. |
| P.M. | PARCEL MAPS, BOOK-PAGE, S.J.C.R. |
| M.&P. | MAPS AND PLATS, BOOK-PAGE, S.J.C.R. |
| S.J.C.R. | SAN JOAQUIN COUNTY RECORDS |
| C.R. | CORNER RECORD, SAN JOAQUIN COUNTY SURVEYOR'S OFFICE |

