


CORNER RECORD

City of STOCKTON

Document Number CR-10-75
County of SAN JOAQUIN, California

Brief Legal Description IN SECTION 48, C.M. WEBER GRANT

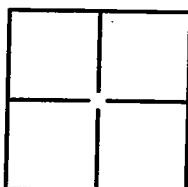

CORNER TYPE

Government Corner ☐ Control ☒
Meander ☐ Property ☐
Rancho ☐ Other ☒

Date of Survey AUGUST 31, 2010

COORDINATES (Optional)

N 2,153,600.05
E 6,348,830.43
Zone 3 NAD27 ☐ NAD83 ☒
NAD83 Epoch 1991.35
Elev. 25.13
Vert. Datum: NVGD29 ☐ NVGD88 ☒
Meas. Units: Metric ☐ Imperial ☐

Corner-- Left as found ☐ Found and tagged ☐ Established ☐ Reestablished ☒ Rebuilt ☐

Identification and type of corner found: Evidence used to identify or procedure used to establish or reestablish the corner:

CENTERLINE MONUMENT ARCH-AIRPORT ROAD - CITY OF STOCKTON MONUMENT # 130 (3-S-7)
MONUMENT WAS DESTROYED DURING RE-CONSTRUCTION.

RE-SET FROM HORIZONTAL TIES AS SHOWN ON PAGE 2.

COORDINATES AND ELEVATION BY SINGLE OCCUPATION STATIC GPS -
CONTROLS LISTED ON SHEET 2

A description of the physical condition of the monument as found and as set or reset:
SEE PAGE 2

SURVEYOR'S STATEMENT

This Corner Record was prepared by me or under my direction in conformance with
the Land Surveyors' Act on OCTOBER 11, 2010,

Signed [Signature] P.L.S. or R.C.E. Number 6406




COUNTY SURVEYOR'S STATEMENT

This Corner Record was received OCTOBER 12, 2010 and examined
and filed NOVEMBER 1, 2010

Signed Thomas M. Gau P.L.S. or R.C.E. No. 23341

PER Title COUNTY SURVEYOR

County Surveyor's Comment _____

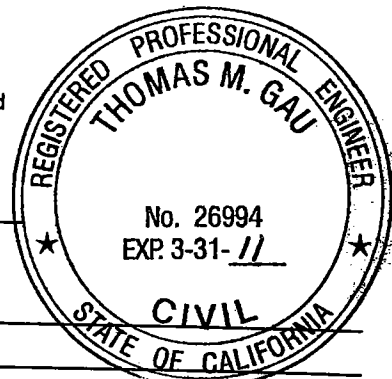

LEGEND:

- SET MONUMENT AS NOTED.
—●— FOUND 1/2" IRON PIPE WITH CAP L.S. 6406, C.R., 10-43
—✱— FOUND PK NAIL AS NOTED.
R.S. RECORD OF SURVEY, BOOK-PAGE, S.J.C.R.
P.M. PARCEL MAPS, BOOK-PAGE, S.J.C.R.
M.&P. MAPS AND PLATS, BOOK-PAGE, S.J.C.R.
S.J.C.R. SAN JOAQUIN COUNTY RECORDS
COS# CITY OF STOCKTON MONUMENT NUMBER
C.R. CORNER RECORD, SAN JOAQUIN COUNTY SURVEYOR'S OFFICE

STATIC GPS CONTROL MONUMENTS

COS#	NORTHING	EASTING	ELEVATION
334	2148117.53	6353716.55	30.01
335	2145030.41	6353714.22	29.48
1006	2156434.07	6348474.30	25.16

COORDINATES AS SHOWN ON 35-SURVEYS-5, S.J.C.R.
ELEVATIONS FROM CITY OF STOCKTON BENCHMARK INDEX.

