
City of					C	County of	San Joa	aquin		_, Califor	nia
Brief Legal D	Description	NORTH	WE	ST CORN	IER	OF R.S.	36-1	86			
		CORNER TYP	E	· · · · · · · · · · · · · · · · · · ·		COORDINATE	S (Option	al)			
						N					
)		Government Cor		Control		E					
		Meander Rancho		Property		Zone					
1	-	Kancho		Other		NAD83 Epoch Elev					
		Date of Survey _	Novem	nber <u>15, 2010</u>		Vert. Datum:				NADV88	
<u></u> <u>L</u>			-			Meas. Units:	i	Metric		Imperial	
orner -	Lef	t as found □	Found	and tagged]	Established [Reestabli	ished 🏻		Rebuilt []
										•	
\ description o	of the physic Survmark	al condition of the Spike with wa	monume sher sta	ent as found a amped L.S.	ind as : 4450	set or reset:		lë l	5510h	AAL LANZ el L. Quaz	E LIP
description o	of the physic Survmark	Spike with wa	sher sta	amped L.S.	ind as : 4450	set or reset:			Sion	NO 4450	CELERON
Set	Survmark	Spike with wa	sher sta	amped L.S. EMENT	4450		1	Harris Ha		NO. 4450 p: 8-30-11	SURPLIE
Set	Survmark	SURVEYOR' repared by me or	S STAT	amped L.S. EMENT	4450	set or reset: nance with the Land	1	* PROSS	Ex	p: 9- 30-11	COLDEGICAL
Set	ecord was p	SURVEYOR' repared by me or	S STAT	TEMENT of direction in a	4450			* Si	Ex		Self Self Self Self Self Self Self Self
Set	ecord was posterior	SURVEYOR'	S STAT under my	EMENT of direction in a	conform	nance with the Land			EX TOO	P: 9-30-11 OF CALIFOR	School Control of the
Set This Corner Re Surveyor's Act Signed	ecord was posterior Michael	SURVEYOR' repared by me or L. Quartaro DUNTY SURVE	S STAT under my	EMENT direction in control P.L.S	conform CORF	nance with the Land			EX TOO	P: 9-30-11 OF CALIFOR	School State of the School
his Corner Re urveyor's Act igned	ecord was post on Dec	SURVEYOR' repared by me or L. Quartaro DUNTY SURVE	S STAT under my	EMENT direction in o	conform	nance with the Land R.C.E. No.:L.S.	4450		EX TOO	P: 9-30-11	Selection of the select
Set This Corner Refurveyor's Act Signed This Corner Refund filed	ecord was position in the Michael	SURVEYOR' repared by me or L. Quartaro OUNTY SURVE	S STAT under my	EMENT / direction in control P.L.S STATEMEN 2.2.2.2.2.2.2.2.2.2.2.2.2.2.2.2.2.2.2	conform	nance with the Land	4450		PROM	F CALIFOR	Self Color C
Set This Corner Re Surveyor's Act Signed	ecord was position in the Michael	SURVEYOR' repared by me or L. Quartaro DUNTY SURVE	S STAT under my	EMENT / direction in control P.L.S STATEMEN 2.2.2.2.2.2.2.2.2.2.2.2.2.2.2.2.2.2.2	conform	nance with the Land R.C.E. No.:L.S.	4450		PROM	F CALIFOR DEESSION AS M. C	School State
Set This Corner Refurveyor's Act Signed This Corner Refund filed Signed This Igned	ecord was portion of Michael	SURVEYOR' repared by me or L. Quartaro DUNTY SURVE received TAN 24 COUNTY SURVE	S STAT under my	EMENT / direction in control P.L.S STATEMEN 2.2.2.2.2.2.2.2.2.2.2.2.2.2.2.2.2.2.2	conform S. OR F	nance with the Land R.C.E. No.:L.S.	4450		PROM	F CALIFOR	School State of the second
his Corner Reurveyor's Actigned	ecord was portion of Michael	SURVEYOR' repared by me or L. Quartaro DUNTY SURVE received TAN 24 COUNTY SURVE	S STAT under my	EMENT / direction in control P.L.S STATEMEN 2.2.2.2.2.2.2.2.2.2.2.2.2.2.2.2.2.2.2	conform S. OR F	nance with the Land R.C.E. No.:L.S.	4450		PROM	F CALIFOR DEESSION AS M. C	Science of the second of the s

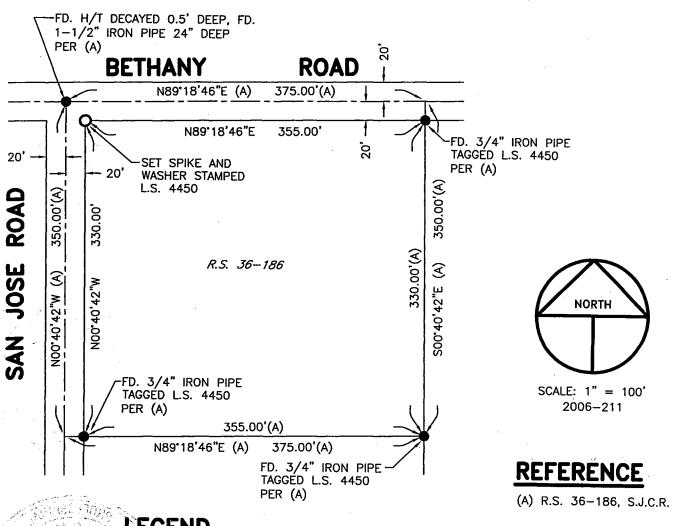

LEGEND

FD. R.S. S.J.C.R. INDICATES FOUND MONUMENT AS NOTED INDICATES FOUND ON THIS SURVEY INDICATES RECORD OF SURVEY, BOOK AND PAGE, S.J.C.R. INDICATES SAN JOAQUIN COUNTY RECORDS