

CORNER RECORD


Document Number

CR-11-14

City of _____

County of SAN JOAQUIN, California

Brief Legal Description

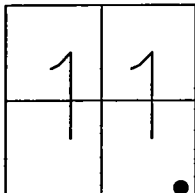A PORTION OF THE SOUTHEAST 1/4 OF SECTION 11, T.3N., R.5E., M.D.B.&M.

T3N, R5E

Government Corner ☐ Control ☐
Meander ☐ Property ☐
Rancho ☐ Other ☒
Date of Survey 11-22-2010

COORDINATES (Optional)

N. _____
E. _____
Zone _____ NAD27 ☐ NAD83 ☐
NAD83 Epoch _____
Elev. _____
Vert. Datum: NGVD29 ☐ NAVD88 ☐
Meas. Units: Metric ☐ Imperial ☐

Corner - Left as found ☐ Found and tagged ☐ Established ☐ Reestablished ☒ Rebuilt ☐

Identification and type of corner found: Evidence used to identify or procedure used to establish or reestablished the corner:

3/4" REBAR TAGGED "LS 5250" IN MONUMENT WELL ON THORNTON ROAD 150'+/- NORTH OF STATE
ROUTE NO. 12 IN THE SOUTHEAST 1/4 OF SECTION 11, T.3N., R.5E., M.D.B.&M. WAS DESTROYED
DURING THE CONSTRUCTION OF THORNTON ROAD IMPROVEMENTS. USED EXISTING FOUND MONUMENTS AS
SHOWN ON MAP FILED IN BOOK 35 OF SURVEYS, AT PAGE 61, SAN JOAQUIN COUNTY RECORDS.

A description of the physical condition of the monument as found and as set or reset: _____

SET 3/4" IRON PIPE TAGGED "LS 6953" IN MONUMENT WELL USING TIES SHOWN ON MAP FILED IN
BOOK 35 OF SURVEYS, AT PAGE 61, SAN JOAQUIN COUNTY RECORDS. (SEE PAGE 2)


This Corner Record was prepared by me or under my direction in conformance with
the Land Surveyors' Act on DECEMBER 28, 2010.


Signed [Signature] L.S. 6953**COUNTY SURVEYOR'S STATEMENT**

This Corner Record was received February 4, 2011 and examined
and filed February 15, 2011.

Signed Thomas M. Gau P.L.S. or R.C.E. No. 26994Title INTERIM COUNTY SURVEYOR

County Surveyors Comment _____

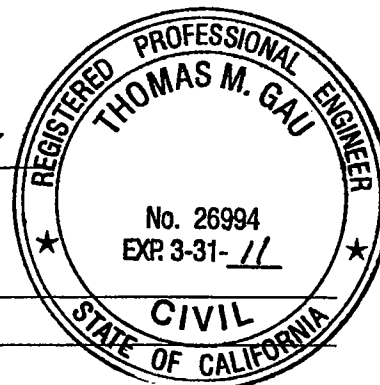

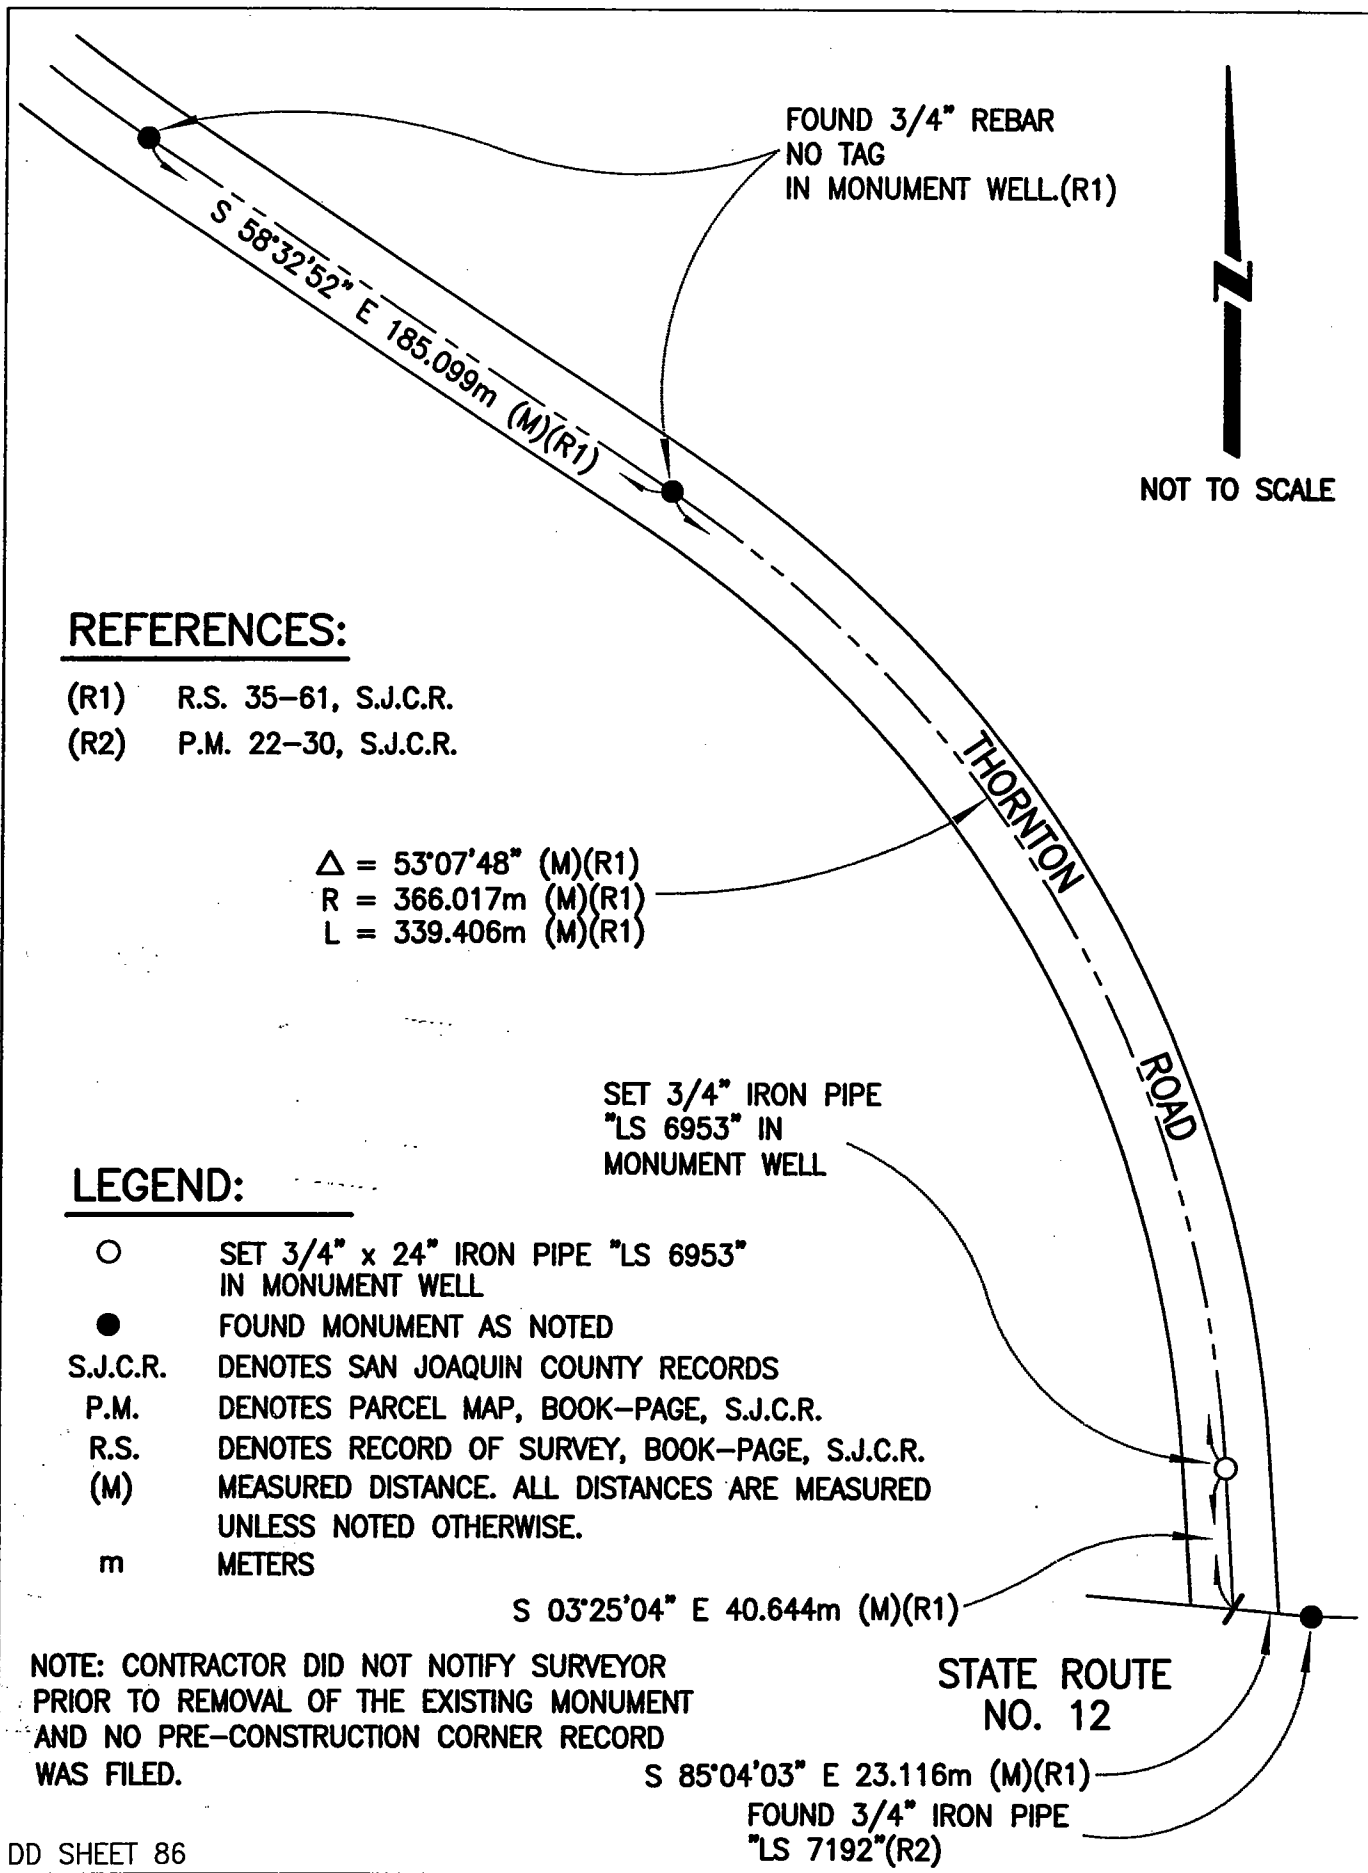

REFERENCES:

- (R1) R.S. 35-61, S.J.C.R.
(R2) P.M. 22-30, S.J.C.R.

$$\begin{aligned}\Delta &= 53^{\circ}07'48'' \text{ (M)(R1)} \\ R &= 366.017\text{m (M)(R1)} \\ L &= 339.406\text{m (M)(R1)}\end{aligned}$$

LEGEND:

- SET 3/4" x 24" IRON PIPE "LS 6953" IN MONUMENT WELL
- FOUND MONUMENT AS NOTED
- S.J.C.R. DENOTES SAN JOAQUIN COUNTY RECORDS
- P.M. DENOTES PARCEL MAP, BOOK-PAGE, S.J.C.R.
- R.S. DENOTES RECORD OF SURVEY, BOOK-PAGE, S.J.C.R.
- (M) MEASURED DISTANCE. ALL DISTANCES ARE MEASURED UNLESS NOTED OTHERWISE.
- m METERS

NOTE: CONTRACTOR DID NOT NOTIFY SURVEYOR PRIOR TO REMOVAL OF THE EXISTING MONUMENT AND NO PRE-CONSTRUCTION CORNER RECORD WAS FILED.