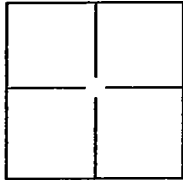


CORNER RECORD

Document Number CL-11-18City of TracyCounty of San Joaquin, CaliforniaBrief Legal Description Parcel "A" as shown on R.S. 17-36 S.J.C.R.**CORNER TYPE**

Government Corner ☐ Control ☐
Meander ☐ Property ☒
Rancho ☐ Other ☐

Date of Survey December 15, 2010**COORDINATES(Optional)**

N. _____
E. _____
Zone _____ NAD27 ☐ NAD83 ☐
NAD83 Epoch _____
Elev. _____
Vert. Datum: NGVD29 ☐ NADV88 ☐
Meas. Units: Metric ☐ Imperial ☒

Corner - Left as found ☐ Found and tagged ☐ Established ☒ Reestablished ☒ Rebuilt ☐

Identification and type of corner found: Evidence used to identify or procedure used to establish or reestablish the corner:

See plat on back.


A description of the physical condition of the monument as found and as set or reset:

Set 3/4"-24" rebar tagged "LS 8080".**SURVEYOR'S STATEMENT**

This Corner Record was prepared by me or under my direction in conformance with
the Land Surveyor's Act on February 22, 2011.

Signed [Signature] P.L.S. or R.C.E. No.: 8080**COUNTY SURVEYOR'S STATEMENT**This Corner Record was received February 22, 2011 and examinedand filed February 28, 2011.Signed [Signature] P.L.S. or R.C.E. No.: 26994Title INTERIM COUNTY SURVEYOR

County Surveyor's Comment _____

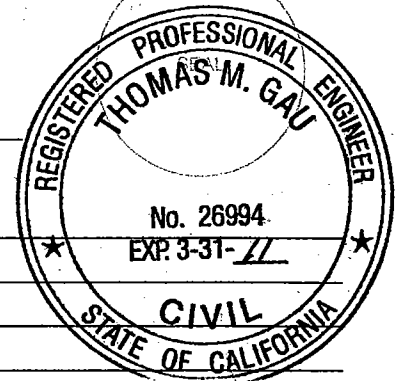

FD. 3/4" IRON PIPE
PLUGGED LS 5412
NO REF.

10.00'(M,A,B)

FD. 3/4" IRON PIN
NO TAG ACCEPTED
AS (B)

SCALE
1"=40'

FD. 1" IRON PIPE NO
TAG ACCEPTED AS (A)

S84°57'45"E
105.44'(M,A)

853.08'(M,B)

S84°57'45"E 115.44'(M,A)

FD. 1" IRON PIPE NO
TAG ACCEPTED AS (A)

FD. 1" IRON PIN NO
TAG ACCEPTED AS (A,B)

206.45'(M) 206.04'(A)
SOUTH 221.51'(M) 221.10'(A)

S00°00'02"W 167.14'(M) 166.80'(A)
152.08'(M) 151.74'(A)

FD. 1" IRON PIPE (A)
NO TAG 0.35'
N00°00'02"E OF CORNER

FD. 1" IRON PIPE NO
TAG ACCEPTED AS (A)

123.21'(M,A)
N68°57'44"E 133.92'(M,A)

FD. 1" IRON PIPE NO
TAG ACCEPTED AS (A)

BASIS OF BEARINGS:

THE WEST LINE OF PARCEL "A"
BEING SOUTH AS
PER R.S. 17-36 S.J.C.R.

LEGEND:

- FD. MONUMENT AS DESCRIBED
- SET 3/4" - 24" REBAR TAGGED "LS8080"
- SFN SEARCHED, FOUND NOTHING

REFERENCES:

- (A) R.S. 17-36, S.J.C.R.
- (B) M. & P. 33-31, S.J.C.R.

D.B. Wilton

LAND SURVEYING

PO BOX 435 LODI CA 95241-0435
(209) 747-0169 dbwsurvey@yahoo.com

PLAT OF PARCEL "A" ON R.S. 17-36
S.J.C.R.