
CORNER RECORD

Document Number __ C.R. 11-60 County of SAN JOAQUIN City of MANTECA Brief Legal Description CENTERLINE INTERSECTION PACIFIC ROAD WITH SOUTH RIGHT-OF-WAY LINE OF WEST YOSEMITE AVENUE. CORNER TYPE COORDINATES (Optional) T.1.S. Government Corner Control 31 | 32 Zone _____ NAD27 NAD83 Meander Property Rancho Other NAD83 Epoch___ T.2.S. Elev. Date of Survey MARCH 18, 2011 Vert. Datum: NVGD29 NVGD88 Meas. Units: Metric Imperial __ Rebuilt Found and tagged Established Reestablished Left as found X Corner-Identification and type of corner found: Evidence used to identify or procedure used to establish or reestablish the corner: FOUND 2" IRON PIPE IN MONUMENT WELL AT CENTERLINE INTERSECTION PACIFIC ROAD WITH SOUTH RIGHT-OF-WAY LINE WEST YOSEMITE AVENUE. 2" IRON PIPE SHOWN ON MAPS FILED IN BOOK 31 OF MAPS AND PLATS AT PAGE 66, BOOK 7 OF SURVEYS AT PAGE 37, AND BOOK 11 OF MAPS AND PLATS AT PAGE 149, SAN JOAQUIN COUNTY RECORDS. A description of the physical condition of the monument as found and as set or reset: MONUMENT IS IN AREA OF RECONSTRUCTION, SET TIES AS SHOWN ON SHEET 2. SURVEYOR'S STATEMENT This Corner Record was prepared by me or under my direction in conformance with P.L.S. or R.C.E. Number 6953 ROFESSIO COUNTY SURVEYOR'S STATEMENT HOMAS M. This Corner Record was received MAY 11, 2011 and examined and filed No. 26994 EXP. 3-31-/ Title INTERIM COUNTY SUNDEYOR County Surveyor's Comment _____

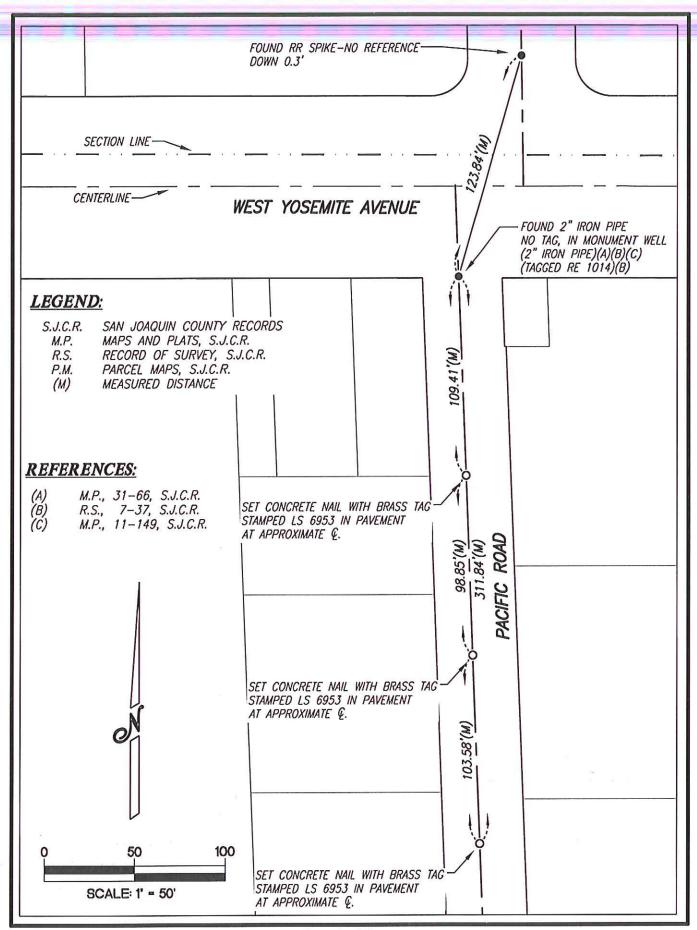

Page 2 of 2