

CORNER RECORD		Document Number <u>CR 11-66</u>	
City of	×	County of San Joaquin, Californic	
Brief Legal Description	LEONARDINI ROAD 1597'± EAST OF CHERRYLAI	ND AVENUE	
(WITHIN SECTION 62	2, C.M. WEBBER GRANT)		
	CORNER TYPE Government Corner □ Control □ Meander □ Property ☒ Rancho □ Other □ Date of Survey December 1, 2010	COORDINATES (Optional) N E	
Corner - Left as fo	und 🛭 Found and tagged 🗌 Established	☐ Reestablished ☐ Rebuilt ☐	
SEE SKETCH ON BACKS	nysical condition of the monument as found and		
	SURVEYOR'S STATEMENT	CSIONAL LAND JORGENSES	
the Land Surveyors' A	P.L.S. Number 8470 OUNTY SURVEYOR'S STATEMENT	LICENSE No. 8470	
This Corner Record vand filed MAY Signed Momas	vas received <u>MAY 18</u> , 2011 and 24, 2011. -M. Gan R.C.E. No. 2	OF CALITY	
Title County Surveyor County Surveyor's Co	omment	No. 26994 EXP. 3-31-13	
(D.D. Sheet No. 32A)		OF CALIFORNIA	

Job No. 220013

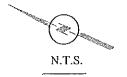

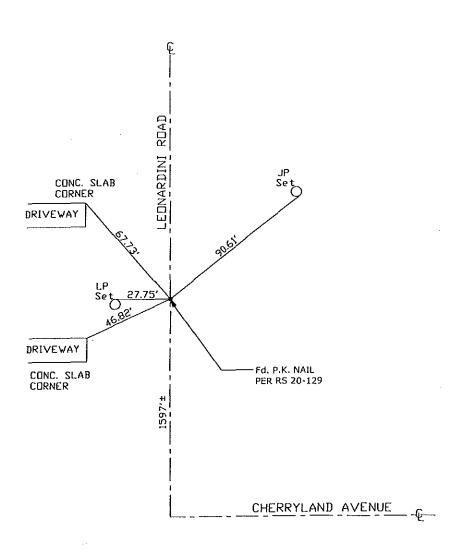

Note: Found Monuments are not tagged unless otherwise noted.

"No Attempt Was Made to Verify the Monument(s)"

Set=Conc. Noil with Bross Washer Stamped
"S.J. Co.", unless otherwise noted
Fd.=Found Conc. Noil with Bross Washer Stamped
"S.J. Co.", unless otherwise noted
FP=Fence Post
JP=Joint Pole
LP=Light Pole
PP=Power Pole
GP=Guy Pole
SP=Service Pole
IP=Telephone Pole
SF.N.=Searched Found Nothing
N.T.S.=Not To Scale
M&P=Maps & Plats
PM=Parcel Map
RS=Record of Survey
FB=Field Book