

CORNER RECORD		Document NumberCR 11-72_
City of		County of San Joaquin, Californic
	LEONARDINI ROAD 147'± WEST OF LAGORIO RC	DAD
(WITHIN SECTION 72,	C.M. WEBER GRANT)	
	CORNER TYPE	COORDINATES (Optional)
		N
	Government Corner Control	7one NAD27 🗆 NAD83 🗇
	Meander	NAD83 Epoch
	Rancho □ Other 🛛	Elev
	Date of Survey December 1, 2010	Vert. Datum: NGVD29 ☐ NAVD88 ☐ Meas. Units: Metric ☐ Imperial ☒
Corner - Left as four	nd ⊠ Found and tagged □ Established	☐ Reestablished ☐ Rebuilt ☐
SEE SKETCH ON BACKSID		ocedure used to establish or reestablish the corner
T		as set or reset:
SEE SKETCH ON BACKSID	E	
the Land Surveyors' Ad Signed 7	SURVEYOR'S STATEMENT orepared by me or under my direction in confoct on	rmance with LICENSE No. 8470
This Corner Record wo	as received MAY 18 2011 and	examined (7)
and filed AMA	124, 2011.	OF CALL
$\subset \mathcal{W}$	m. Bau R.C.E. No. 2	6994
Signed Morror	R.C.E. NO.	PROFESSION A
Title County Sur	veyor	COMAS M. CA
County Surveyor's Cor	nment	(S) No. 26994
		110/1
		EXP. 3-31-13
		- CIVILAR
(D.D. Sheet No. 32A)		OF CALIFO

Job No. 220013

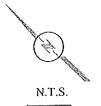

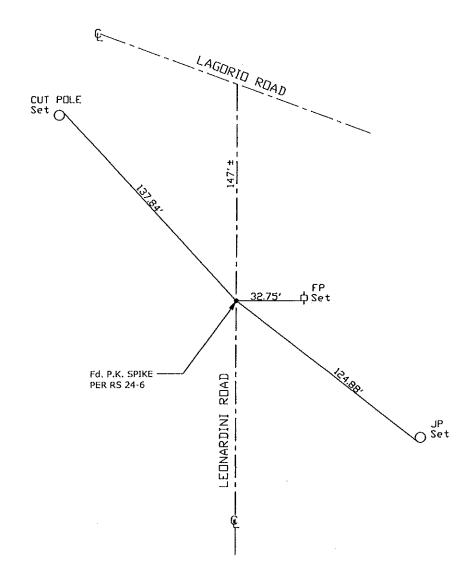

Note: Found Monuments are not tagged unless otherwise noted.

"No Attempt Was Made to Verify the Monument(s)"

Set=Conc. Nail with Bross Washer Stamped
"S.J. Co.", unless otherwise noted
Fd.=Found Conc. Nail with Bross Washer Stamped
"S.J. Co.", unless otherwise noted
FP=Fence Post
JP=Joint Pole
EP=Light Pole
PP=Power Pole
GP=Guy Pole
SP=Service Pole
TP=Telephone Pole
SF.N.=Searched Found Nothing
N.I.S.=Not To Scale
M&P=Mops & Plats
PM=Parcel Mop
RS=Record of Survey
FB=Field Book