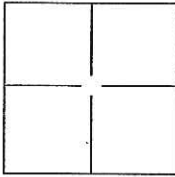


# CORNER RECORD

Document Number CR 11-111City of STOCKTONCounty of SAN JOAQUIN, CaliforniaBrief Legal Description PEBBLE BEACH DRIVE, M.&P. 32-85, SEC. 31, T.2N., R.6E., M.D.B.&M.**CORNER TYPE**

Government Corner ☐ Control ☐  
Meander ☐ Property ☐  
Rancho ☐ Other ☒

Date of Survey MAY 3, 2011**COORDINATES(Optional)**

N. \_\_\_\_\_  
E. \_\_\_\_\_  
Zone \_\_\_\_\_ NAD27 ☐ NAD83 ☐  
NAD83 Epoch \_\_\_\_\_  
Elev. \_\_\_\_\_  
Vert. Datum: NGVD29 ☐ NADV88 ☐  
Meas. Units: Metric ☐ Imperial ☐

Corner - Left as found ☒ Found and tagged ☐ Established ☐ Reestablished ☐ Rebuilt ☐

Identification and type of corner found: Evidence used to identify or procedure used to establish or reestablish the corner:  
SEE PLAT ON BACK

A description of the physical condition of the monument as found and as set or reset:

FOUND 3/4" REBAR WITH CAP ATTACHED AND STAMPED "LS 4334" IN MONUMENT WELL AND CHISELED CROSS AT 2.00' OFFSET ON LOT LINE PROJECTION PER M.&P. 32-85.

**SURVEYOR'S STATEMENT**


This Corner Record was prepared by me or under my direction in conformance with the Land Surveyor's Act on MAY 27, 2011.

Signed William M. Koch P.L.S. or R.C.E. No.: 8092**COUNTY SURVEYOR'S STATEMENT**

This Corner Record was received JULY 18, 2011 and examined and filed JULY, 2011.

Signed Thomas M. Gau P.L.S. or R.C.E. No.: 26994Title COUNTY SURVEYOR

County Surveyor's Comment \_\_\_\_\_

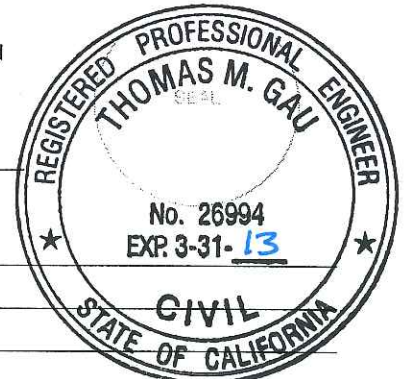

D.D. SHEET 29C

**LEGEND:**

M.&amp;P. BOOK OF MAPS AND PLATS, VOLUME-PAGE

+ FOUND CHISELED CROSS ON 2' OFFSET PER M.&amp;P. 32-85

● FOUND  $\frac{3}{4}$ " REBAR W/CAP ATTACHED AND STAMPED "LS 4334" IN MONUMENT WELL PER M.&P. 32-85**BASIS OF BEARINGS:**

THE CENTERLINE OF PEBBLE BEACH DRIVE WHICH BEARS N25°47'59"E PER M.&amp;P. 32-85

