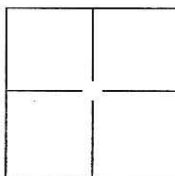


CORNER RECORD

Document Number CR 11-112City of STOCKTONCounty of SAN JOAQUIN, CaliforniaBrief Legal Description SPANISH BAY CIRCLE, M.&P. 35-66, SEC. 31, T.2N., R.6E., M.D.B.&M.**CORNER TYPE**

Government Corner ☐ Control ☐
Meander ☐ Property ☐
Rancho ☐ Other ☒

Date of Survey MAY 4, 2011**COORDINATES(Optional)**

N. _____
E. _____
Zone _____ NAD27 ☐ NAD83 ☐
NAD83 Epoch _____
Elev. _____
Vert. Datum: NGVD29 ☐ NADV88 ☐
Meas. Units: Metric ☐ Imperial ☐

Corner - Left as found ☒ Found and tagged ☐ Established ☐ Reestablished ☐ Rebuilt ☐

Identification and type of corner found: Evidence used to identify or procedure used to establish or reestablish the corner:

SEE PLAT ON BACK

A description of the physical condition of the monument as found and as set or reset:


FOUND 3/4" REBAR WITH CAP ATTACHED AND STAMPED "LS 4334" IN MONUMENT WELL AND
CHISELED CROSS AT 2.00' OFFSET ON LOT LINE PROJECTION PER M.&P. 35-66.

SURVEYOR'S STATEMENT

This Corner Record was prepared by me or under my direction in conformance with

the Land Surveyor's Act on MAY 27, 2011.Signed William M. Koch P.L.S. or R.C.E. No.: 8092**COUNTY SURVEYOR'S STATEMENT**This Corner Record was received JULY 18, 2011 and examinedand filed JULY 27, 2011.Signed Thomas M. Gau P.L.S. or R.C.E. No.: 26994Title COUNTY SURVEYOR

County Surveyor's Comment _____

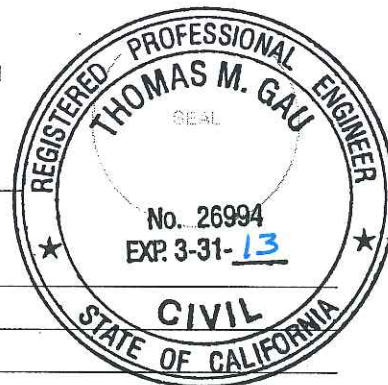

LEGEND:


- M.&P. BOOK OF MAPS AND PLATS, VOLUME-PAGE
 + FOUND CHISELED CROSS ON 2' OFFSET PER M.&P. 35-66
 ⊙ FOUND ¾" REBAR W/CAP ATTACHED AND STAMPED "LS 4334" IN MONUMENT WELL PER M.&P. 35-66
 ○ SET PK NAIL W/TAG STAMPED "LS 8092"

BASIS OF BEARINGS:

THE CENTERLINE OF SPANISH BAY CIRCLE WHICH BEARS S46°00'52"W PER M.&P. 35-66

0' 50' 100' 200'

SCALE: 1"=100'

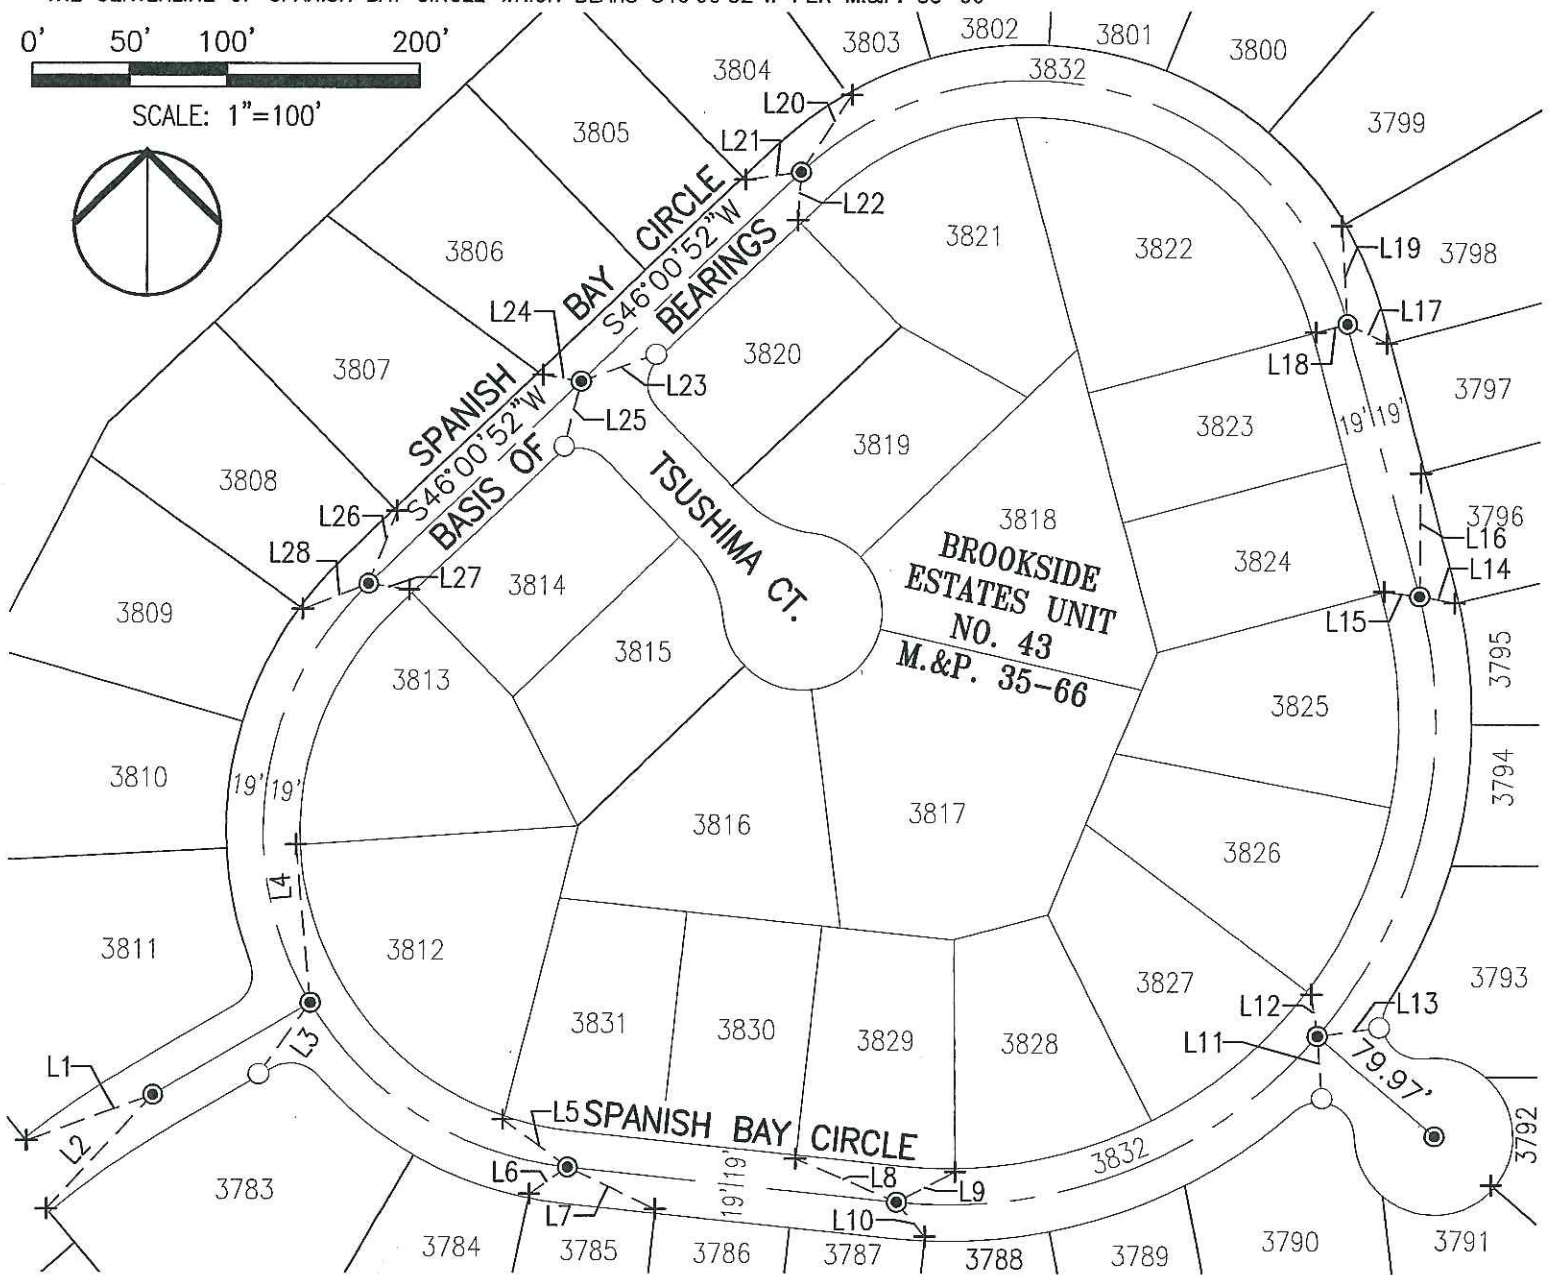

LINE TABLE		
LINE #	DIRECTION	LENGTH
L1	S69°44'29"W	69.15'
L2	N42°34'25"E	80.77'
L3	S35°30'10"W	45.74'
L4	S5°20'00"E	82.44'
L5	N53°38'27"W	41.94'
L6	N54°48'42"E	24.44'
L7	N64°31'08"W	50.89'

LINE TABLE		
LINE #	DIRECTION	LENGTH
L8	N66°35'13"W	56.98'
L9	S62°28'36"W	34.25'
L10	S39°23'20"E	23.42'
L11	N4°07'52"W	32.64'
L12	N8°16'33"W	21.85'
L13	S82°05'20"W	32.39'
L14	S79°50'51"E	18.58'

LINE TABLE		
LINE #	DIRECTION	LENGTH
L15	S83°16'32"E	18.34'
L16	N0°23'44"E	64.05'
L17	S63°34'35"E	22.58'
L18	S75°17'45"W	17.13'
L19	S3°35'05"E	51.30'
L20	S32°42'14"W	47.89'
L21	N81°53'46"E	28.89'

LINE TABLE		
LINE #	DIRECTION	LENGTH
L22	S3°31'39"W	25.22'
L23	N70°16'53"E	41.52'
L24	N80°31'23"W	20.01'
L25	S14°19'48"W	35.13'
L26	S21°04'03"W	40.45'
L27	S81°21'47"E	21.48'
L28	N68°41'35"E	36.53'