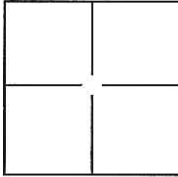


CORNER RECORD

Document Number CR 11-121City of STOCKTONCounty of SAN JOAQUIN, CaliforniaBrief Legal Description PINE LAKE CIRCLE AND PINE LAKE COURT, M.&P. 34-10, SEC. 30 AND 31,
T.2N., R.6E., M.D.B.&M.**CORNER TYPE**

Government Corner	<input type="checkbox"/>	Control	<input type="checkbox"/>
Meander	<input type="checkbox"/>	Property	<input type="checkbox"/>
Rancho	<input type="checkbox"/>	Other	<input checked="" type="checkbox"/>

Date of Survey MAY 9, 2011**COORDINATES(Optional)**

N. _____
E. _____
Zone _____ NAD27 ☐ NAD83 ☐
NAD83 Epoch _____
Elev. _____
Vert. Datum: NGVD29 ☐ NADV88 ☐
Meas. Units: Metric ☐ Imperial ☐

Corner - Left as found ☒ Found and tagged ☐ Established ☐ Reestablished ☐ Rebuilt ☐

Identification and type of corner found: Evidence used to identify or procedure used to establish or reestablish the corner:

SEE PLAT ON BACK

A description of the physical condition of the monument as found and as set or reset:

FOUND 3/4" REBAR WITH CAP ATTACHED AND STAMPED "LS 4876" IN MONUMENT WELL
AND CHISELED CROSS ON LOT LINE PROJECTION PER M.&P. 34-10.**SURVEYOR'S STATEMENT**


This Corner Record was prepared by me or under my direction in conformance with
the Land Surveyor's Act on JUNE 14, 2011.

Signed William M. Koch P.L.S. or R.C.E. No.: 8092**COUNTY SURVEYOR'S STATEMENT**

This Corner Record was received JULY 18, 2011 and examined
and filed AUGUST 3, 2011.

Signed Thomas M. Gau P.L.S. or R.C.E. No.: 26994Title COUNTY SURVEYOR

County Surveyor's Comment _____

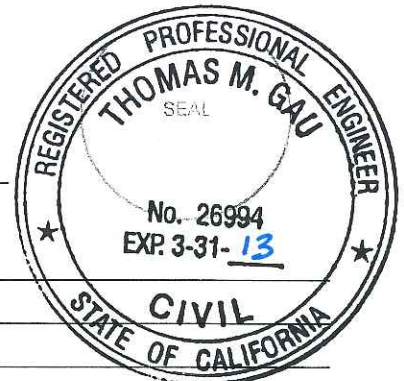

LEGEND:

- M.&P. BOOK OF MAPS AND PLATS, VOLUME-PAGE
 + FOUND CHISELED CROSS ON 2' OFFSET (LOTS 2177-2179 & 2187-2207) AND 5.6' OFFSET (LOTS 2151-2176 & 2180-2186) PER M.&P. 34-10
 ● FOUND 3/4" REBAR W/CAP ATTACHED AND STAMPED "LS 4876" IN MONUMENT WELL PER M.&P. 34-10
 ○ SET PK NAIL W/TAG STAMPED "LS 8092"

BASIS OF BEARINGS:

THE CENTERLINE OF PINE LAKE CIRCLE WHICH BEARS S40°00'52"W PER M.&P. 34-10

LINE TABLE		
LINE #	DIRECTION	LENGTH
L1	N58°10'40"E	27.65'
L2	N63°07'28"W	17.79'
L3	N15°29'11"W	29.09'
L4	N24°16'09"E	56.68'
L5	S84°36'42"E	18.43'
L6	N81°05'31"W	22.22'

LINE TABLE		
LINE #	DIRECTION	LENGTH
L7	N16°21'05"W	16.71'
L8	N31°40'07"E	41.81'
L9	S31°05'25"W	45.87'
L10	S64°42'59"E	39.00'
L11	N87°01'23"E	39.06'

