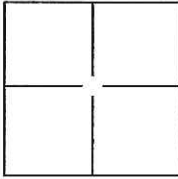


CORNER RECORD

Document Number CR 11-122City of STOCKTONCounty of SAN JOAQUIN, CaliforniaBrief Legal Description PINE LAKE CIRCLE, DOVERTON DRIVE AND PINE LAKE COURT, M.&P. 33-17 AND M.&P. 34-10, SEC. 30 AND 31, T.2N., R.6E., M.D.B.&M.**CORNER TYPE**

Government Corner	☐	Control	☐
Meander	☐	Property	☐
Rancho	☐	Other	☒

Date of Survey MAY 11, 2011**COORDINATES(Optional)**

N. _____
E. _____
Zone _____ NAD27 ☐ NAD83 ☐
NAD83 Epoch _____
Elev. _____
Vert. Datum: NGVD29 ☐ NADV88 ☐
Meas. Units: Metric ☐ Imperial ☐

Corner - Left as found ☒ Found and tagged ☐ Established ☐ Reestablished ☐ Rebuilt ☐

Identification and type of corner found: Evidence used to identify or procedure used to establish or reestablish the corner:

SEE PLAT ON BACK

A description of the physical condition of the monument as found and as set or reset: _____

FOUND 3/4" REBAR WITH CAP ATTACHED AND STAMPED "LS 4876" IN MONUMENT WELL
AND CHISELED CROSS ON LOT LINE PROJECTION PER M.&P. 33-17 AND M.&P. 34-10.

SURVEYOR'S STATEMENT


This Corner Record was prepared by me or under my direction in conformance with
the Land Surveyor's Act on JUNE 14, 2011.

Signed WM M Koch P.L.S. or R.C.E. No.: 8092**COUNTY SURVEYOR'S STATEMENT**

This Corner Record was received JULY 28, 2011 and examined
and filed AUGUST 3, 2011.

Signed Thomas M. Gau P.L.S. or R.C.E. No.: 26994Title COUNTY SURVEYOR

County Surveyor's Comment _____

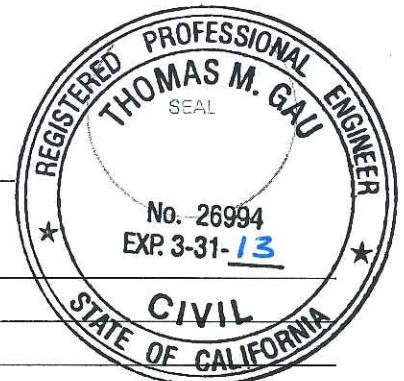

LEGEND:

M.&P. BOOK OF MAPS AND PLATS, VOLUME-PAGE
 + FOUND CHISELED CROSS PER M.&P. 33-17 AND M.&P. 34-10
 ● FOUND ¾" REBAR W/CAP ATTACHED AND STAMPED "LS 4876" IN MONUMENT WELL PER M.&P. 33-17 AND M.&P. 34-10
 ○ SET PK NAIL W/TAG STAMPED "LS 8092"


BASIS OF BEARINGS:

THE CENTERLINE OF PINE LAKE CIRCLE WHICH BEARS N47°59'08"W PER P.M. 33-17

LINE TABLE		
LINE #	DIRECTION	LENGTH
L1	N70°02'38"W	41.42'
L2	N75°52'58"W	44.82'
L3	N40°34'59"W	39.95'
L4	S60°30'48"E	30.46'
L5	S14°42'46"E	35.56'
L6	N88°11'03"W	24.06'
L7	N3°39'29"W	27.22'
L8	N31°46'58"W	44.13'

LINE TABLE		
LINE #	DIRECTION	LENGTH
L9	N31°00'51"W	56.64'
L10	N68°55'23"E	15.56'
L11	N72°38'33"E	19.17'
L12	S70°29'26"E	43.38'
L13	S9°26'09"E	15.49'
L14	N11°01'40"E	54.43'
L15	N23°55'04"W	75.73'
L16	S76°10'06"W	39.10'

LINE TABLE		
LINE #	DIRECTION	LENGTH
L17	N22°18'29"W	39.03'
L18	N7°28'16"W	38.06'
L19	S16°23'13"E	73.86'
L20	N69°22'58"W	42.18'
L21	N39°14'58"E	36.49'
L22	N72°46'16"E	21.11'

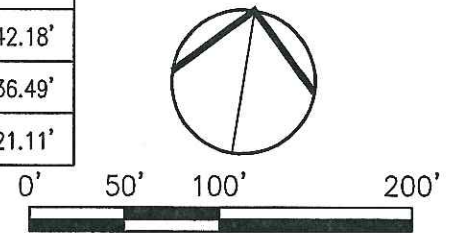

SCALE: 1"=100'

