

CORNER RECORD


Document Number CR 11-145
County of SAN JOAQUIN, California

City of MANTECA

Brief Legal Description APPARENT CENTERLINE GRAND PRIX AVENUE AT APPARENT SOUTH LINE WEST YOSEMITE AVENUE IN THE NORTHEAST CORNER OF SECTION 6, T.2S., R.7E., M.D.B.&M.

CORNER TYPE

COORDINATES (Optional)

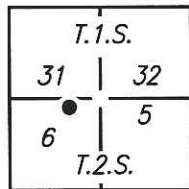

Government Corner ☐ Control ☐
Meander ☐ Property ☐
Rancho ☐ Other ☒

Date of Survey JULY 28, 2011

N _____
E _____
Zone _____ NAD27 ☐ NAD83 ☐
NAD83 Epoch _____
Elev. _____
Vert. Datum: NVGD29 ☐ NVGD88 ☐
Meas. Units: Metric ☐ Imperial ☐

Corner— Left as found ☐ Found and tagged ☐ Established ☐ Reestablished ☒ Rebuilt ☐


Identification and type of corner found: Evidence used to identify or procedure used to establish or reestablish the corner:
CENTERLINE MONUMENT AT APPARENT CENTERLINE GRAND PRIX AVENUE AND APPARENT SOUTH LINE WEST YOSEMITE AVENUE WAS DESTROYED DURING CONSTRUCTION. FOUND WITNESS CORNERS AS SHOWN ON CORNER RECORD DOCUMENT NUMBER 11-61.

A description of the physical condition of the monument as found and as set or reset: SET MONUMENT FROM TIES AS SHOWN ON PAGE 2.

SURVEYOR'S STATEMENT

This Corner Record was prepared by me or under my direction in conformance with the Land Surveyors' Act on AUGUST 3, 2011,

Signed [Signature] P.L.S. or R.C.E. Number 6953

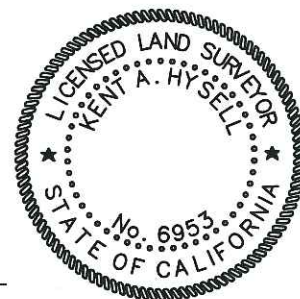

COUNTY SURVEYOR'S STATEMENT

This Corner Record was received SEPTEMBER 9, 2011 and examined and filed SEPTEMBER 14, 2011

Signed Thomas M. Gau P.L.S. or R.C.E. No: 26994

Title COUNTY SURVEYOR

County Surveyor's Comment _____

