
CORNER RECORD Document Number ______ CL //-/6/ City of _____ County of San Joaquin, California Brief Legal Description SOUTHLAND ROAD 2098' +/- EAST OF AUSTIN ROAD (WITHIN SECTION 26, TOWNSHIP 1 SOUTH, RANGE 7 EAST, MOUNT DIABLO BASE & MERIDIAN) **CORNER TYPE** COORDINATES (Optional) Government Corner Control Zone NAD27 - NAD83 -Meander Property NAD83 Epoch_ Other Rancho Elev. Vert. Datum: NGVD29 □ NAVD88 Date of Survey September 27, 2011 Meas. Units: Metric □ Imperial 🛛 Corner -Left as found ☐ Found and tagged ☐ Established ☐ Reestablished □ Rebuilt ☑ Identification and type of corner found: Evidence used to identify or procedure used to establish or reestablish the corner: SEE SKETCH ON BACKSIDE. A description of the physical condition of the monument as found and as set or reset: SEE SKETCH ON BACKSIDE. SURVEYOR'S STATEMENT This Corner Record was prepared by me or under my direction in conformance with September 28 the Land Surveyors' Act on ___ , 2011. P.L.S. Number <u>8657</u> LICENSE Signed No. 865 COUNTY SURVEYOR'S STATEMENT This Corner Record was received 5676456x 28, 2011 and examined and filed OCTOBER ____, 2011. M. Hau R.C.E. No. 26994 Signed __ Title County Surveyor County Surveyor's Comment_____ (D.D. Sheet No. 46)

(Job No. 220792)

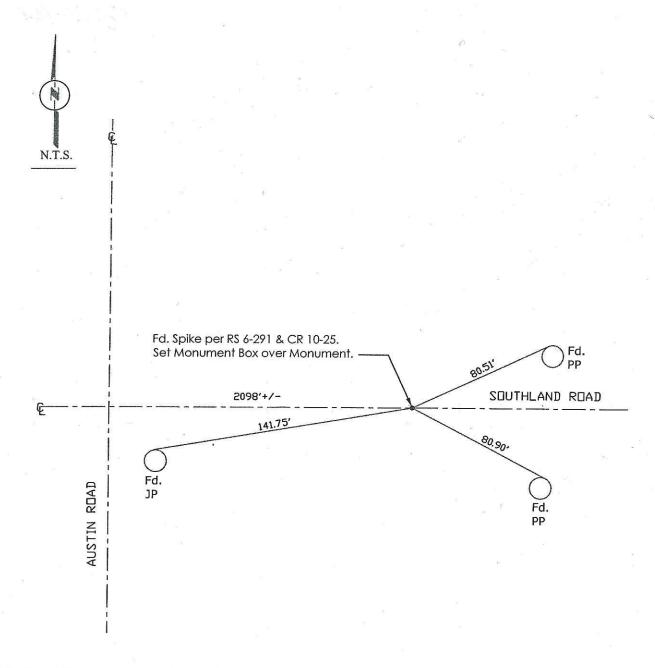

Note: Found Monuments are not tagged unless otherwise noted.

"No Attempt Was Made to Verify the Monument(s)"

Set=Conc. Nail with Brass Washer Stamped
"S.J. Co.", unless otherwise noted
Fd.=Found Conc. Nail with Brass Washer Stamped
"S.J. Co.", unless otherwise noted
CR=Corner Record
FP=Fence Post
GP=Guy Pole
JP=Joint Pole
JP=Joint Pole
SP=Service Pole
SP=Service Pole
TP=Telephone Pole
S.F.N.=Searched Found Nothing
N.T.S.=Not To Scale
M&P=Maps & Plats
PM=Parcel Map
RS=Record of Survey
FB=Field Book