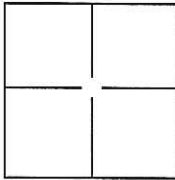


CORNER RECORD

Document Number CR 11-169City of STOCKTONCounty of SAN JOAQUIN, CaliforniaBrief Legal Description RIVERBROOK COURT, M.&P. 35-34, SEC. 30, T.2N., R.6E., M.D.B.&M.**CORNER TYPE**

Government Corner	<input type="checkbox"/>	Control	<input type="checkbox"/>
Meander	<input type="checkbox"/>	Property	<input type="checkbox"/>
Rancho	<input type="checkbox"/>	Other	<input checked="" type="checkbox"/>

Date of Survey MAY 20, 2011**COORDINATES(Optional)**

N. _____
E. _____
Zone _____ NAD27 ☐ NAD83 ☐
NAD83 Epoch _____
Elev. _____
Vert. Datum: NGVD29 ☐ NADV88 ☐
Meas. Units: Metric ☐ Imperial ☐

Corner - Left as found ☒ Found and tagged ☐ Established ☐ Reestablished ☐ Rebuilt ☐

Identification and type of corner found: Evidence used to identify or procedure used to establish or reestablish the corner:
SEE PLAT ON BACK

A description of the physical condition of the monument as found and as set or reset: _____
FOUND 3/4" REBAR WITH CAP ATTACHED AND STAMPED "LS 4334" IN MONUMENT WELL AND
CHISELED CROSS ON LOT LINE PROJECTION PER M.&P. 35-34.

SURVEYOR'S STATEMENT


This Corner Record was prepared by me or under my direction in conformance with
the Land Surveyor's Act on SEPTEMBER 14, 2011.

Signed William M. Koch P.L.S. or R.C.E. No.: 8092**COUNTY SURVEYOR'S STATEMENT**

This Corner Record was received SEPTEMBER 23, 2011 and examined
and filed OCTOBER 20, 2011

Signed Thomas M. Gau P.L.S. or R.C.E. No.: 26994Title COUNTY SURVEYOR

County Surveyor's Comment _____

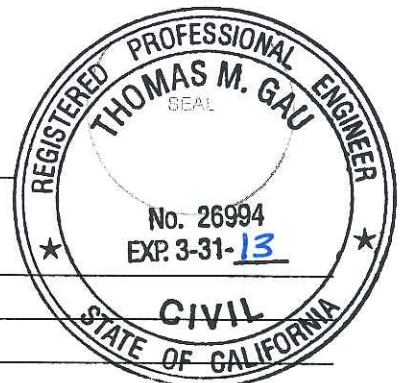

LEGEND:

M.&P. BOOK OF MAPS AND PLATS, VOLUME-PAGE
SFN SEARCHED, FOUND NOTHING
+ FOUND CHISELED CROSS PER M.&P. 35-34
● FOUND $\frac{3}{4}$ " REBAR W/CAP ATTACHED AND STAMPED "LS 4334" IN MONUMENT WELL PER M.&P. 35-34
○ SET PK NAIL W/TAG STAMPED "PLS 8092" IN TOP OF CURB

BASIS OF BEARINGS:

THE CENTERLINE OF RIVERBROOK COURT WHICH BEARS N01°18'18"E PER M.&P. 35-34

