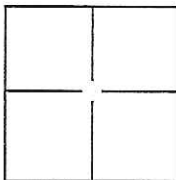


CORNER RECORD

Document Number CL 11-170City of STOCKTONCounty of SAN JOAQUIN, CaliforniaBrief Legal Description PINE MEADOW CIRCLE, LARK HAVEN COURT, MELODY COURT AND SPRING MEADOW LANE, M.&P. 36-46, SEC. 30, T.2N., R.6E., M.D.B.&M.**CORNER TYPE**

Government Corner	☐	Control	☐
Meander	☐	Property	☐
Rancho	☐	Other	☒

Date of Survey MAY 20, 2011**COORDINATES(Optional)**

N. _____
E. _____
Zone _____ NAD27 ☐ NAD83 ☐
NAD83 Epoch _____
Elev. _____
Vert. Datum: NGVD29 ☐ NADV88 ☐
Meas. Units: Metric ☐ Imperial ☐

Corner - Left as found ☒ Found and tagged ☐ Established ☐ Reestablished ☐ Rebuilt ☐

Identification and type of corner found: Evidence used to identify or procedure used to establish or reestablish the corner:
SEE PLAT ON BACK

A description of the physical condition of the monument as found and as set or reset: _____

FOUND 3/4" REBAR WITH CAP ATTACHED AND STAMPED "LS 7079" IN MONUMENT WELL AND CHISELED CROSS ON LOT LINE PROJECTION PER M.&P. 36-46.

SURVEYOR'S STATEMENT


This Corner Record was prepared by me or under my direction in conformance with the Land Surveyor's Act on SEPTEMBER 14, 2011.

Signed [Signature] P.L.S. or R.C.E. No.: 8092**COUNTY SURVEYOR'S STATEMENT**

This Corner Record was received SEPTEMBER 23, 2011 and examined and filed OCTOBER 20, 2011.

Signed [Signature] P.L.S. or R.C.E. No.: 26994Title COUNTY SURVEYOR

County Surveyor's Comment _____

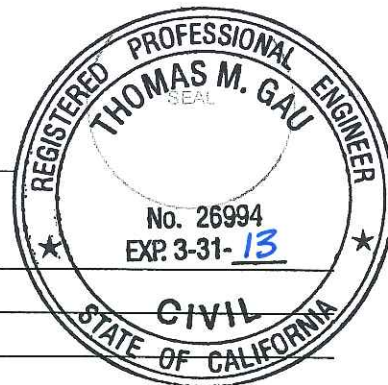


LEGEND:

- M.&P. BOOK OF MAPS AND PLATS, VOLUME-PAGE
+ FOUND CHISELED CROSS PER M.&P. 36-46
● FOUND $\frac{3}{4}$ " REBAR W/CAP ATTACHED AND STAMPED "LS 7079" IN MONUMENT WELL PER M.&P. 36-46
△ FOUND MONUMENT WELL W/2' STRADS, NO MONUMENT IN MONUMENT WELL
○ SET PK NAIL W/TAG STAMPED "PLS 8092"

BASIS OF BEARINGS:

THE CENTERLINE OF PINE MEADOW CIRCLE
WHICH BEARS S88°41'42"E PER M.&P. 36-46

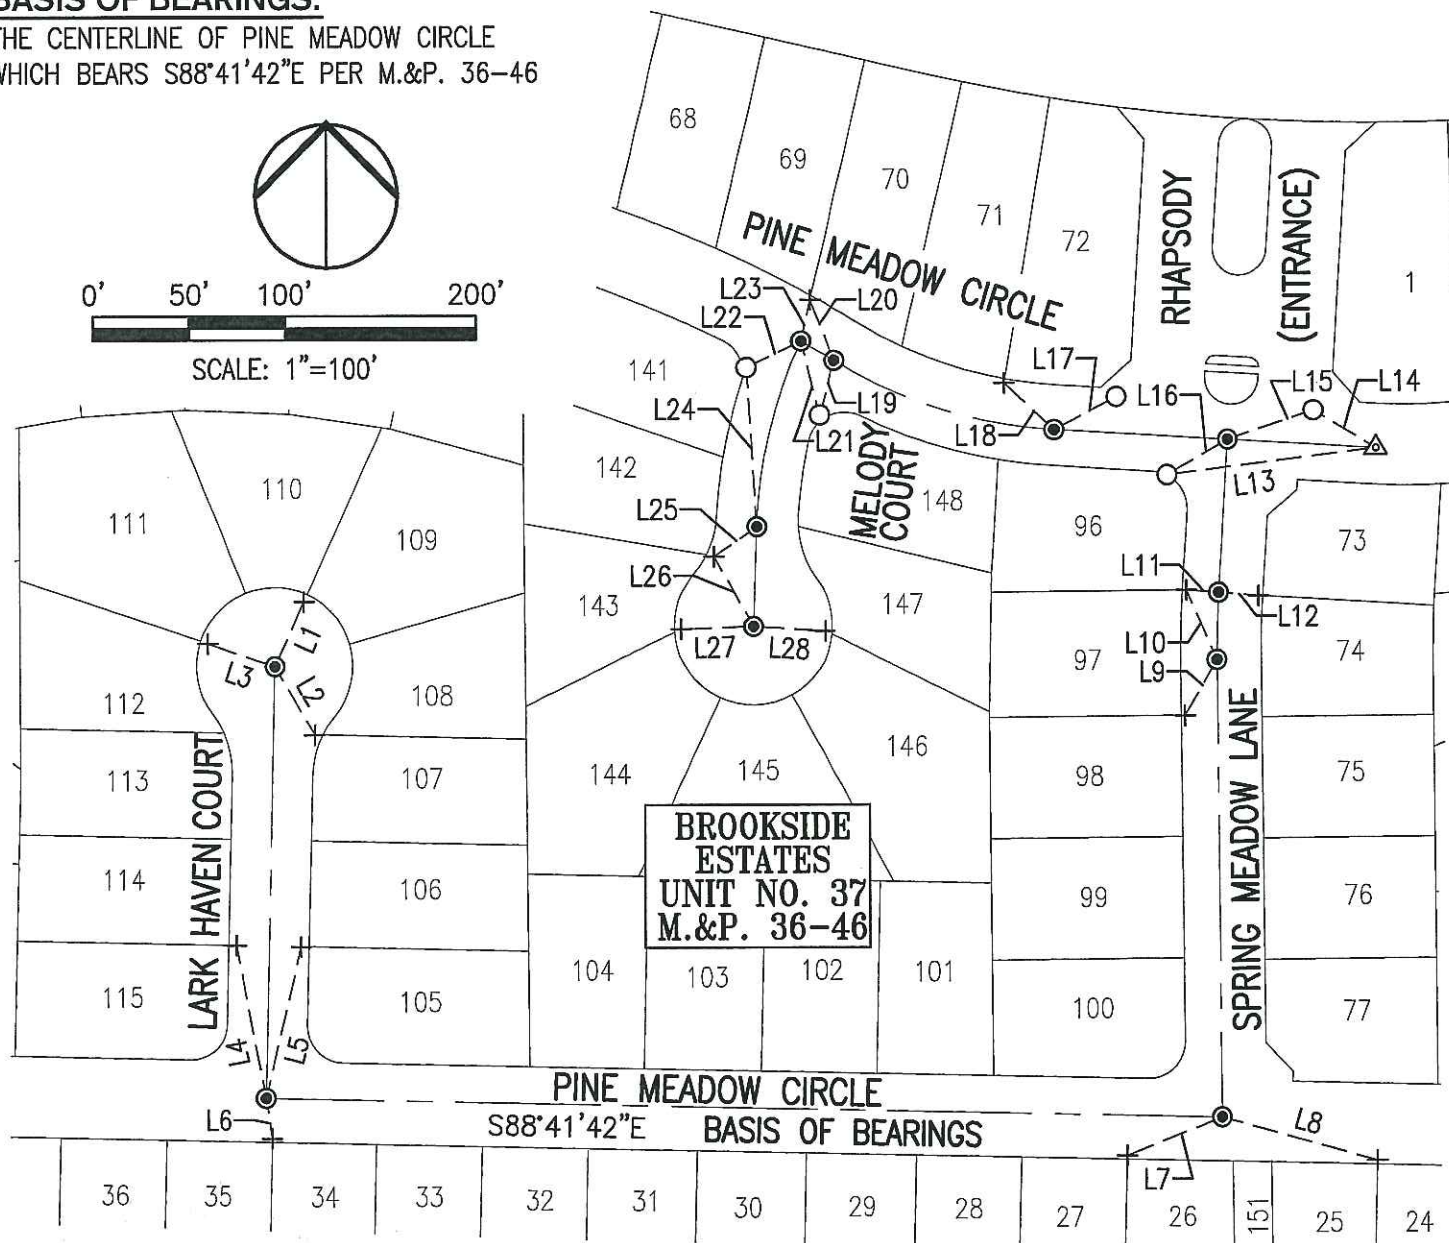

LINE TABLE			LINE TABLE			LINE TABLE			LINE TABLE		
LINE #	DIRECTION	LENGTH	LINE #	DIRECTION	LENGTH	LINE #	DIRECTION	LENGTH	LINE #	DIRECTION	LENGTH
L1	S24°36'46"W	37.02'	L8	N74°22'07"W	84.42'	L15	S71°29'27"W	47.57'	L22	S64°25'48"W	31.63'
L2	N30°36'22"W	41.48'	L9	S30°01'28"W	33.46'	L16	S60°01'53"W	36.46'	L23	N12°22'49"E	22.03'
L3	N71°15'15"W	37.02'	L10	N23°49'28"W	39.61'	L17	N62°10'45"E	36.70'	L24	N3°41'14"W	82.90'
L4	N10°51'22"W	80.81'	L11	N85°40'32"W	17.02'	L18	N46°51'48"W	35.61'	L25	N54°55'19"E	26.89'
L5	S13°25'30"W	80.80'	L12	N85°09'06"W	20.97'	L19	S14°34'43"W	29.38'	L26	S29°07'48"E	41.62'
L6	N8°16'23"W	21.32'	L13	S82°56'00"W	110.30'	L20	N21°16'46"W	33.90'	L27	S87°54'50"W	37.33'
L7	S68°11'57"W	53.50'	L14	S58°56'02"E	38.26'	L21	N14°02'22"W	39.69'	L28	N86°06'43"W	37.29'