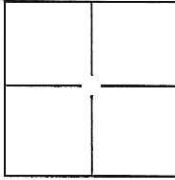


# CORNER RECORD

Document Number CL 11-774City of STOCKTONCounty of SAN JOAQUIN, CaliforniaBrief Legal Description ROCKWOOD CIRCLE AND ROCKWOOD COURT, M.&P. 35-10, SEC. 30,  
T.2N., R.6E., M.D.B.&M.**CORNER TYPE**

|                   |                          |          |                                     |
|-------------------|--------------------------|----------|-------------------------------------|
| Government Corner | <input type="checkbox"/> | Control  | <input type="checkbox"/>            |
| Meander           | <input type="checkbox"/> | Property | <input type="checkbox"/>            |
| Rancho            | <input type="checkbox"/> | Other    | <input checked="" type="checkbox"/> |

Date of Survey MAY 26, 2011**COORDINATES(Optional)**

N. \_\_\_\_\_  
E. \_\_\_\_\_  
Zone \_\_\_\_\_ NAD27 ☐ NAD83 ☐  
NAD83 Epoch \_\_\_\_\_  
Elev. \_\_\_\_\_  
Vert. Datum: NGVD29 ☐ NADV88 ☐  
Meas. Units: Metric ☐ Imperial ☐

Corner - Left as found ☒ Found and tagged ☐ Established ☐ Reestablished ☐ Rebuilt ☐

Identification and type of corner found: Evidence used to identify or procedure used to establish or reestablish the corner:  
SEE PLAT ON BACK

A description of the physical condition of the monument as found and as set or reset: \_\_\_\_\_  
FOUND 3/4" REBAR WITH CAP ATTACHED AND STAMPED "LS 4334" IN MONUMENT WELL AND  
CHISELED CROSS ON LOT LINE PROJECTION PER M.&P. 35-10.

**SURVEYOR'S STATEMENT**


This Corner Record was prepared by me or under my direction in conformance with  
the Land Surveyor's Act on SEPTEMBER 14, 2011.

Signed William M. Koch P.L.S. or R.G.E. No.: 8092**COUNTY SURVEYOR'S STATEMENT**

This Corner Record was received SEPTEMBER 23, 2011 and examined  
and filed OCTOBER 20, 2011.


Signed Thomas M. Gau P.L.S. or R.C.E. No.: 26994Title COUNTY SURVEYOR

County Surveyor's Comment \_\_\_\_\_

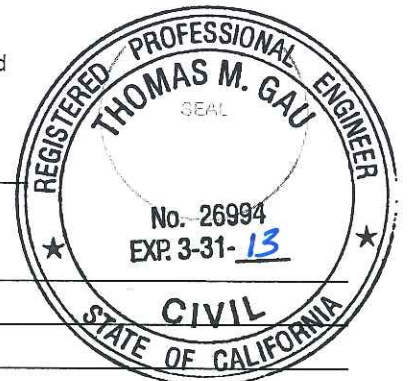


**LEGEND:**

- M.&P. BOOK OF MAPS AND PLATS, VOLUME-PAGE  
 + FOUND CHISELED CROSS PER M.&P. 35-10  
 ● FOUND  $\frac{3}{4}$ " REBAR W/CAP ATTACHED AND STAMPED "LS 4334" IN MONUMENT WELL PER M.&P. 35-10  
 ○ SET PK NAIL W/TAG STAMPED "PLS 8092"

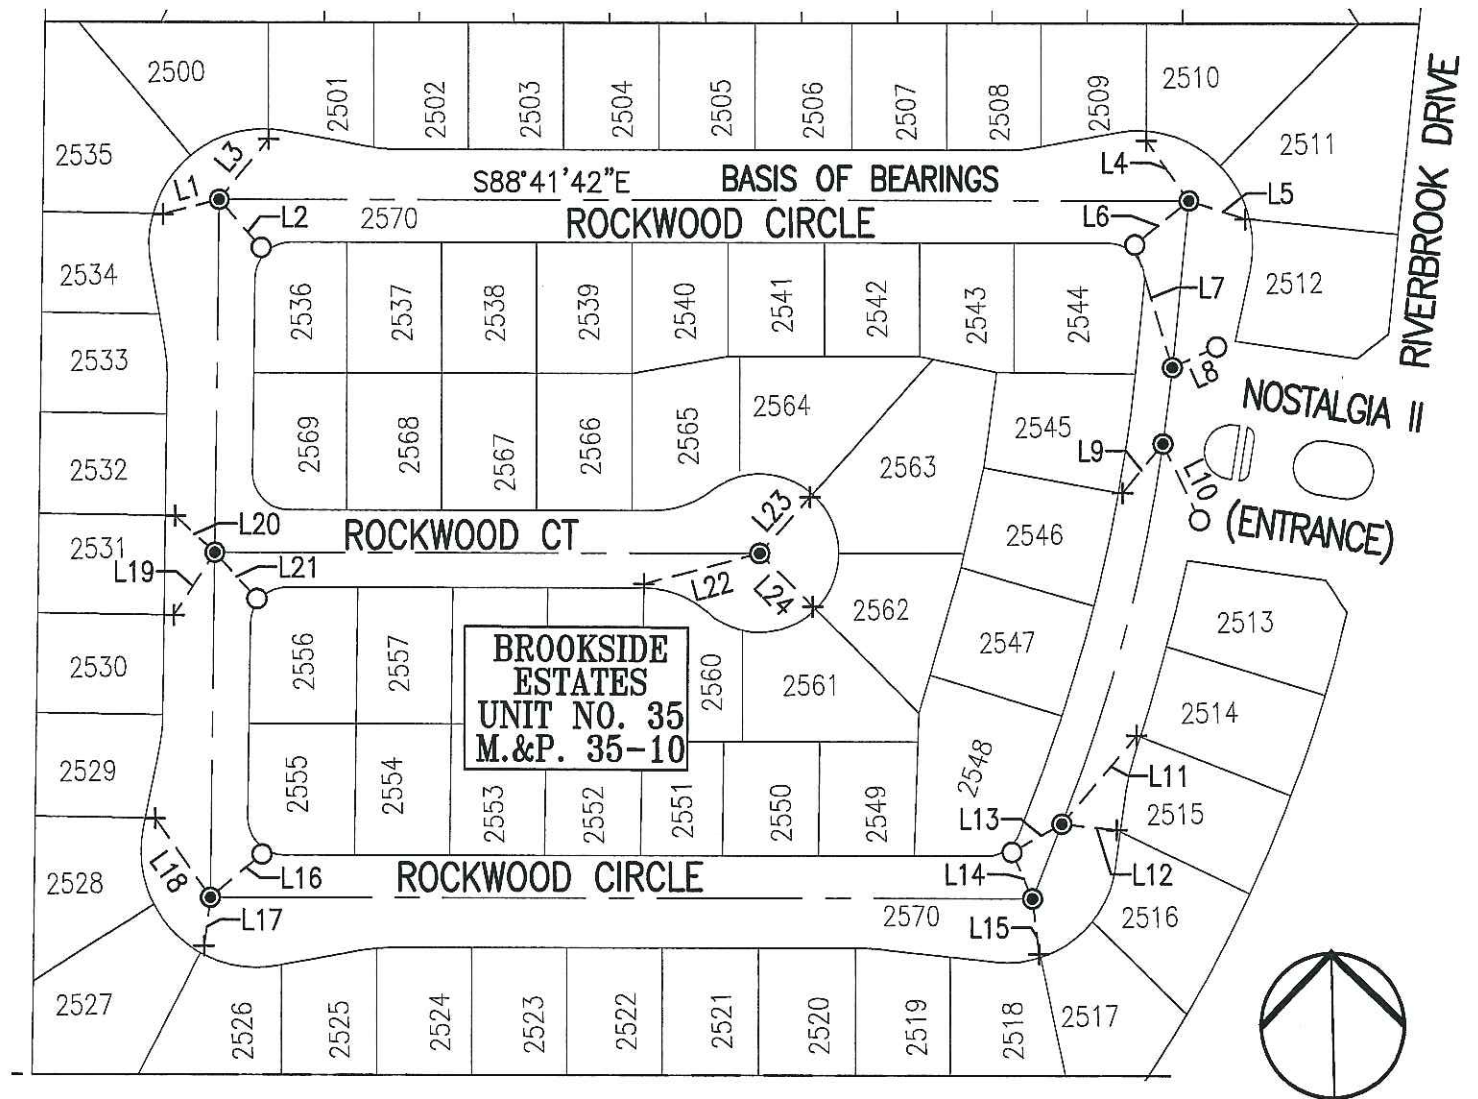**BASIS OF BEARINGS:**

THE CENTERLINE OF ROCKWOOD CIRCLE WHICH  
 BEARS S88°41'42"E PER M.&P. 35-10

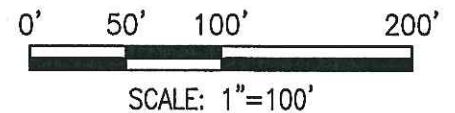

| LINE TABLE |             |        |
|------------|-------------|--------|
| LINE #     | DIRECTION   | LENGTH |
| L1         | S76°47'24"W | 30.42' |
| L2         | N39°56'34"W | 33.08' |
| L3         | S40°31'13"W | 40.53' |
| L4         | S34°12'08"E | 38.19' |
| L5         | S70°53'59"E | 31.14' |
| L6         | N52°25'12"E | 36.46' |

| LINE TABLE |             |        |
|------------|-------------|--------|
| LINE #     | DIRECTION   | LENGTH |
| L7         | N15°54'25"W | 66.68' |
| L8         | S66°16'36"W | 25.51' |
| L9         | N41°11'57"E | 33.16' |
| L10        | S24°26'37"E | 43.68' |
| L11        | S41°39'20"W | 59.94' |
| L12        | S82°17'33"E | 28.46' |

| LINE TABLE |             |        |
|------------|-------------|--------|
| LINE #     | DIRECTION   | LENGTH |
| L13        | N62°07'37"E | 30.02' |
| L14        | S22°54'43"E | 26.36' |
| L15        | S5°20'04"E  | 29.05' |
| L16        | S51°20'32"W | 34.93' |
| L17        | N8°50'02"E  | 25.31' |
| L18        | N33°51'29"W | 50.04' |

| LINE TABLE |             |        |
|------------|-------------|--------|
| LINE #     | DIRECTION   | LENGTH |
| L19        | N34°28'03"E | 39.06' |
| L20        | N46°31'27"W | 27.97' |
| L21        | N41°07'03"W | 32.48' |
| L22        | N76°33'36"E | 62.48' |
| L23        | N43°12'48"E | 38.91' |
| L24        | N43°34'23"W | 38.88' |