
CORNER RECORD	7 89	Document Number	211-202
City of	N W	County of San Joaqu	
Brief Legal Description ACAMPO ROAD @ D	ES MOINES ROAD AND 13	15' +/- WEST	5 S
Government Corner Meander Rancho Date of Survey No.	□ Property ⊠ □ Other □	COORDINATES (N	D27
Corner - Left as found 🛛 Found and ta	gged Established	☐ Reestablished ☐ F	Rebuilt
A description of the physical condition of the SEE SKETCH ON BACKSIDE.		as set or reset:	
COUNTY SURVEYOR'S S' This Corner Record was received NOVEN and filed DECEMBER 12	der my direction in confo 14, 2011. P.L.S. Number <u>8657</u> TATEMENT 18ER 28_, 2011 and 6 _, 2011.	examined S A S OF	ICENSE O. 8657
Signed Non-11 - Bluc Title County Surveyor	R.C.E. No. <u>26</u>	994 PROPRO	ESSIONAL CALL
County Surveyor's Comment THIS CORNER RECORD IS NOT IN COMPLIANCE REGARDING SUBMITTAL WITHIN 90 DAYS OF S		c)	. 26994 3-31-13
		West C	IVI
(D.D. Sheet No. 12) (Job No. 220011)		OF OF	CALIFO

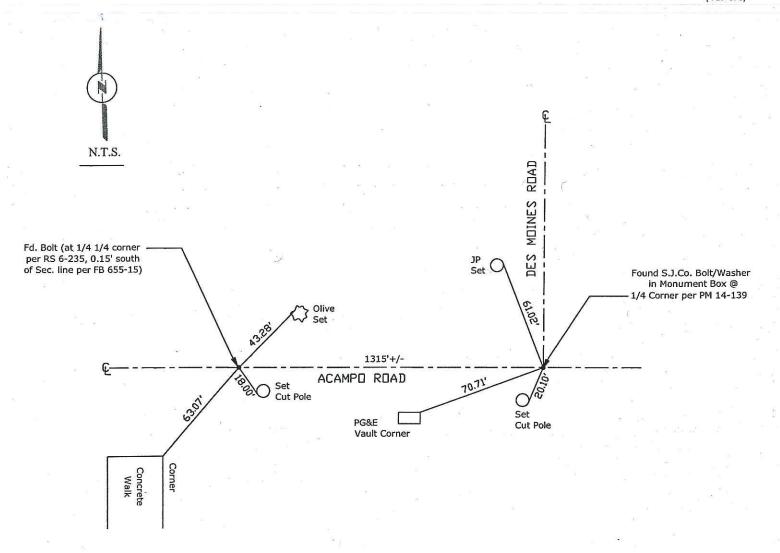

Note: Found Monuments are not tagged unless otherwise noted.

"No Attempt Was Made to Verify the Monument(s)"

Set=Conc. Nail with Brass Washer Stamped
"S.J. Co.", unless otherwise noted
Fd.=Found Conc. Nail with Brass Washer Stamped
"S.J. Co.", unless otherwise noted
FP=Fence Post JP=Joint Pole LP=Light Pole PP=Power Pole GP=Guy Pole SP=Service Pole SP=Service Pole
TP=Telephone Pole
S.F.N.=Searched Found Nothing
N.T.S.=Not To Scale
M&P=Maps & Plats
PM=Parcel Map
RS=Record of Survey

FB=Field Book