


# CORNER RECORD

Document Number CR-12-09  
City of STOCKTON County of SAN JOAQUIN, California

Brief Legal Description RIVERBROOK COURT, M.&P. 35-34, SEC. 30, T.2N., R.6E., M.D.B.&M.

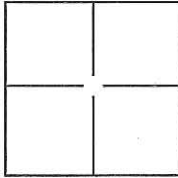

## CORNER TYPE

Government Corner ☐ Control ☐  
Meander ☐ Property ☐  
Rancho ☐ Other ☒

Date of Survey NOVEMBER 23 2011

## COORDINATES(Optional)

N. \_\_\_\_\_  
E. \_\_\_\_\_  
Zone \_\_\_\_\_ NAD27 ☐ NAD83 ☐  
NAD83 Epoch \_\_\_\_\_  
Elev. \_\_\_\_\_  
Vert. Datum: NGVD29 ☐ NADV88 ☐  
Meas. Units: Metric ☐ Imperial ☐

Corner - Left as found ☐ Found and tagged ☐ Established ☐ Reestablished ☒ Rebuilt ☐

Identification and type of corner found: Evidence used to identify or procedure used to establish or reestablish the corner:

SEE PLAT ON BACK

A description of the physical condition of the monument as found and as set or reset: \_\_\_\_\_

SET 3/4", 30" REBAR LONG WITH CAP ATTACHED AND STAMPED "LS 8247" IN MONUMENT WELL.

## SURVEYOR'S STATEMENT

This Corner Record was prepared by me or under my direction in conformance with

the Land Surveyor's Act on DECEMBER 19, 2011.

Signed [Signature] P.L.S. or R.G.E. No.: 8247



## COUNTY SURVEYOR'S STATEMENT


This Corner Record was received January 9, 2012 and examined

and filed February 8, 2012.

Signed Thomas M. Gau P.L.S. or R.C.E. No.: 26994

Title County Surveyor

County Surveyor's Comment \_\_\_\_\_

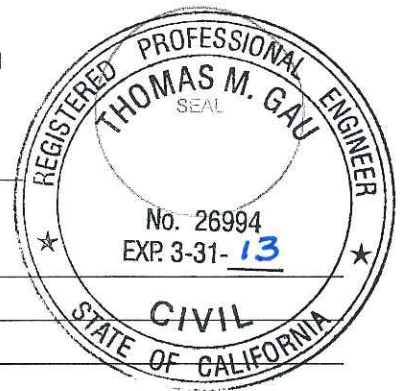

## LEGEND:

M.&P.	BOOK OF MAPS AND PLATS, VOLUME-PAGE
SFN	SEARCHED, FOUND NOTHING
+	FOUND CHISELED CROSS PER M.&P. 35-34
⊙	SET ¾", 30" LONG REBAR W/CAP ATTACHED AND STAMPED "PLS 8247" IN MONUMENT WELL.
●	FOUND PK NAIL W/TAG STAMPED "PLS 8092" IN TOP OF CURB, PER CORNER RECORD 11-169
⊙	FOUND 3/4" REBAR W/CAP ATTACHED AND STAMPED "LS 4334" IN MONUMENT WELL, NOT DISTURBED

## BASIS OF BEARINGS:

THE CENTERLINE OF RIVERBROOK COURT WHICH BEARS N01°18'18"E PER M.&P. 35-34

