


CORNER RECORD

Document Number CR-12-10

City of STOCKTON

County of SAN JOAQUIN, California

Brief Legal Description PINE MEADOW CIRCLE, LARK HAVEN COURT, MELODY COURT AND SPRING MEADOW LANE, M.&P. 36-46, SEC. 30, T.2N., R.6E., M.D.B.&M.

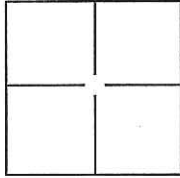

CORNER TYPE

Government Corner ☐ Control ☐
Meander ☐ Property ☐
Rancho ☐ Other ☒

Date of Survey DECEMBER 02, 2011

COORDINATES(Optional)

N. _____
E. _____
Zone _____ NAD27 ☐ NAD83 ☐
NAD83 Epoch _____
Elev. _____
Vert. Datum: NGVD29 ☐ NADV88 ☐
Meas. Units: Metric ☐ Imperial ☐

Corner - Left as found ☐ Found and tagged ☐ Established ☐ Reestablished ☒ Rebuilt ☐

Identification and type of corner found: Evidence used to identify or procedure used to establish or reestablish the corner:

SEE PLAT ON BACK

A description of the physical condition of the monument as found and as set or reset: _____

SET 3/4", 30" LONG REBAR WITH CAP ATTACHED AND STAMPED "LS 8247" IN MONUMENT WELL

SURVEYOR'S STATEMENT

This Corner Record was prepared by me or under my direction in conformance with

the Land Surveyor's Act on DECEMBER 19, 2011.

Signed [Signature] P.L.S. or R.G.E. No.: 8247



COUNTY SURVEYOR'S STATEMENT


This Corner Record was received January 9, 2012 and examined

and filed February 8, 2012

Signed Thomas M. Gau P.L.S. or R.C.E. No.: 26994

Title County Surveyor

County Surveyor's Comment _____

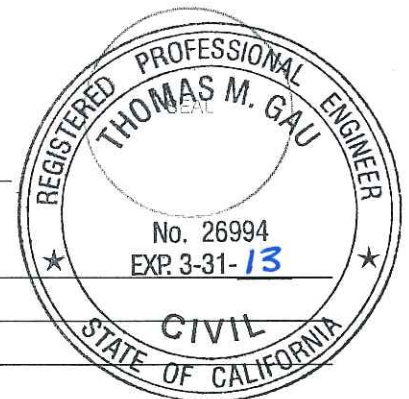


LEGEND:

- M.&P. BOOK OF MAPS AND PLATS, VOLUME-PAGE
+ FOUND CHISELED CROSS PER M.&P. 36-46
⊙ SET 3/4", 30" LONG REBAR W/CAP ATTACHED AND STAMPED "LS 8247" IN MONUMENT WELL
△ FOUND MONUMENT WELL W/2' STRADS, NO MONUMENT IN MONUMENT WELL
● FOUND PK NAIL W/TAG STAMPED "PLS 8092", PER CORNER RECORD CR 11-170
⊙ FOUND 3/4" REBAR W/CAP ATTACHED AND STAMPED "LS 7079" IN MONUMENT WELL, NOT DISTURBED

BASIS OF BEARINGS:

THE CENTERLINE OF PINE MEADOW CIRCLE
WHICH BEARS S88°41'42"E PER M.&P. 36-46

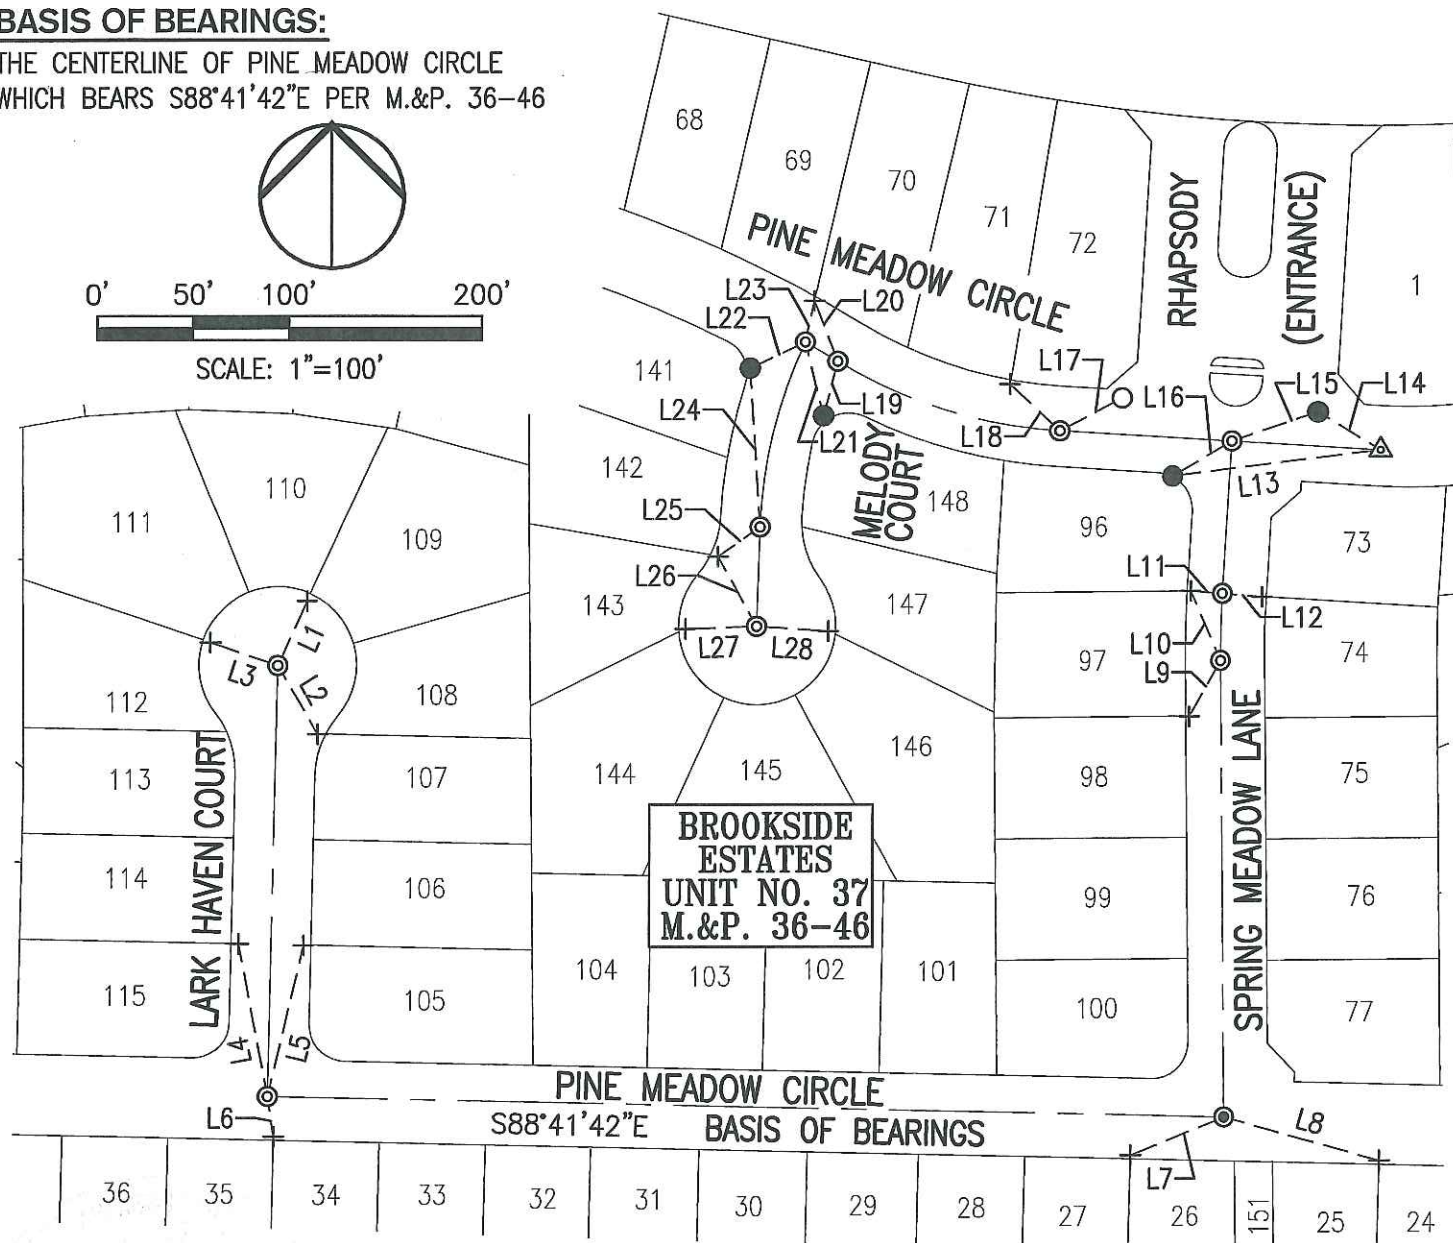

LINE TABLE			LINE TABLE			LINE TABLE			LINE TABLE		
LINE #	DIRECTION	LENGTH	LINE #	DIRECTION	LENGTH	LINE #	DIRECTION	LENGTH	LINE #	DIRECTION	LENGTH
L1	S24°36'46"W	37.02'	L8	N74°22'07"W	84.42'	L15	S71°29'27"W	47.57'	L22	S64°25'48"W	31.63'
L2	N30°36'22"W	41.48'	L9	S30°01'28"W	33.46'	L16	S60°01'53"W	36.46'	L23	N12°22'49"E	22.03'
L3	N71°15'15"W	37.02'	L10	N23°49'28"W	39.61'	L17	N62°10'45"E	36.70'	L24	N3°41'14"W	82.90'
L4	N10°51'22"W	80.81'	L11	N85°40'32"W	17.02'	L18	N46°51'48"W	35.61'	L25	N54°55'19"E	26.89'
L5	S13°25'30"W	80.80'	L12	N85°09'06"W	20.97'	L19	S14°34'43"W	29.38'	L26	S29°07'48"E	41.62'
L6	N8°16'23"W	21.32'	L13	S82°56'00"W	110.30'	L20	N21°16'46"W	33.90'	L27	S87°54'50"W	37.33'
L7	S68°11'57"W	53.50'	L14	S58°56'02"E	38.26'	L21	N14°02'22"W	39.69'	L28	N86°06'43"W	37.29'