


CORNER RECORD

Document Number CR-12-13

City of STOCKTON

County of SAN JOAQUIN, California

Brief Legal Description BRIDLEWOOD CIRCLE AND WINDY COVE CIRCLE, M.&P. 35-77, SEC. 30,
T.2N., R.6E., M.D.B.&M.

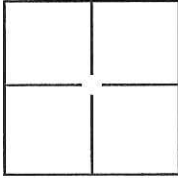

CORNER TYPE

Government Corner ☐ Control ☐
Meander ☐ Property ☐
Rancho ☐ Other ☒

Date of Survey DECEMBER 05, 2011

COORDINATES(Optional)

N. _____
E. _____
Zone _____ NAD27 ☐ NAD83 ☐
NAD83 Epoch _____
Elev. _____
Vert. Datum: NGVD29 ☐ NADV88 ☐
Meas. Units: Metric ☐ Imperial ☐

Corner - Left as found ☐ Found and tagged ☐ Established ☐ Reestablished ☒ Rebuilt ☐

Identification and type of corner found: Evidence used to identify or procedure used to establish or reestablish the corner:

SEE PLAT ON BACK

A description of the physical condition of the monument as found and as set or reset: _____

SET 3/4", 30" LONG REBAR WITH CAP ATTACHED AND STAMPED "LS 8247" IN MONUMENT WELL.

SURVEYOR'S STATEMENT

This Corner Record was prepared by me or under my direction in conformance with

the Land Surveyor's Act on DECEMBER 19, 2011.

Signed [Signature] P.L.S. or R.G.E. No.: 8247



COUNTY SURVEYOR'S STATEMENT


This Corner Record was received January 9, 2012 and examined

and filed February 8, 2012.

Signed Thomas M. Gau P.L.S. or R.C.E. No.: 26994

Title County Surveyor

County Surveyor's Comment _____

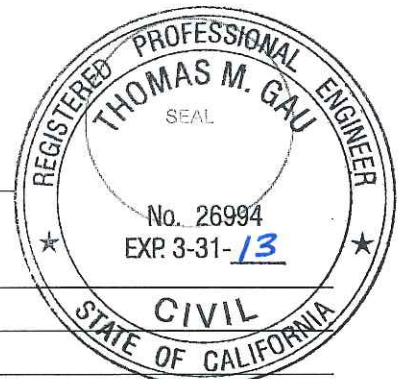

LEGEND:

M.&P. BOOK OF MAPS AND PLATS, VOLUME-PAGE

✕ FOUND PK NAIL, NO REF.

+ FOUND CHISELED CROSS PER M.&P. 35-77

⊙ SET 3/4" REBAR, 30" LONG W/CAP ATTACHED AND STAMPED "LS 8247" IN MONUMENT WELL

● FOUND PK NAIL W/TAG STAMPED "PLS 8092" PER RECORD CORNER CR 11-173

⊙ FOUND 3/4" REBAR W/CAP ATTACHED AND STAMPED "LS 4334" IN MONUMENT WELL, NOT DISTURBED


0' 50' 100' 200'

SCALE: 1"=100'

BASIS OF BEARINGS:

THE CENTERLINE OF BRIDLEWOOD CIRCLE WHICH

BEARS S88°41'42"E PER M.&P. 35-77

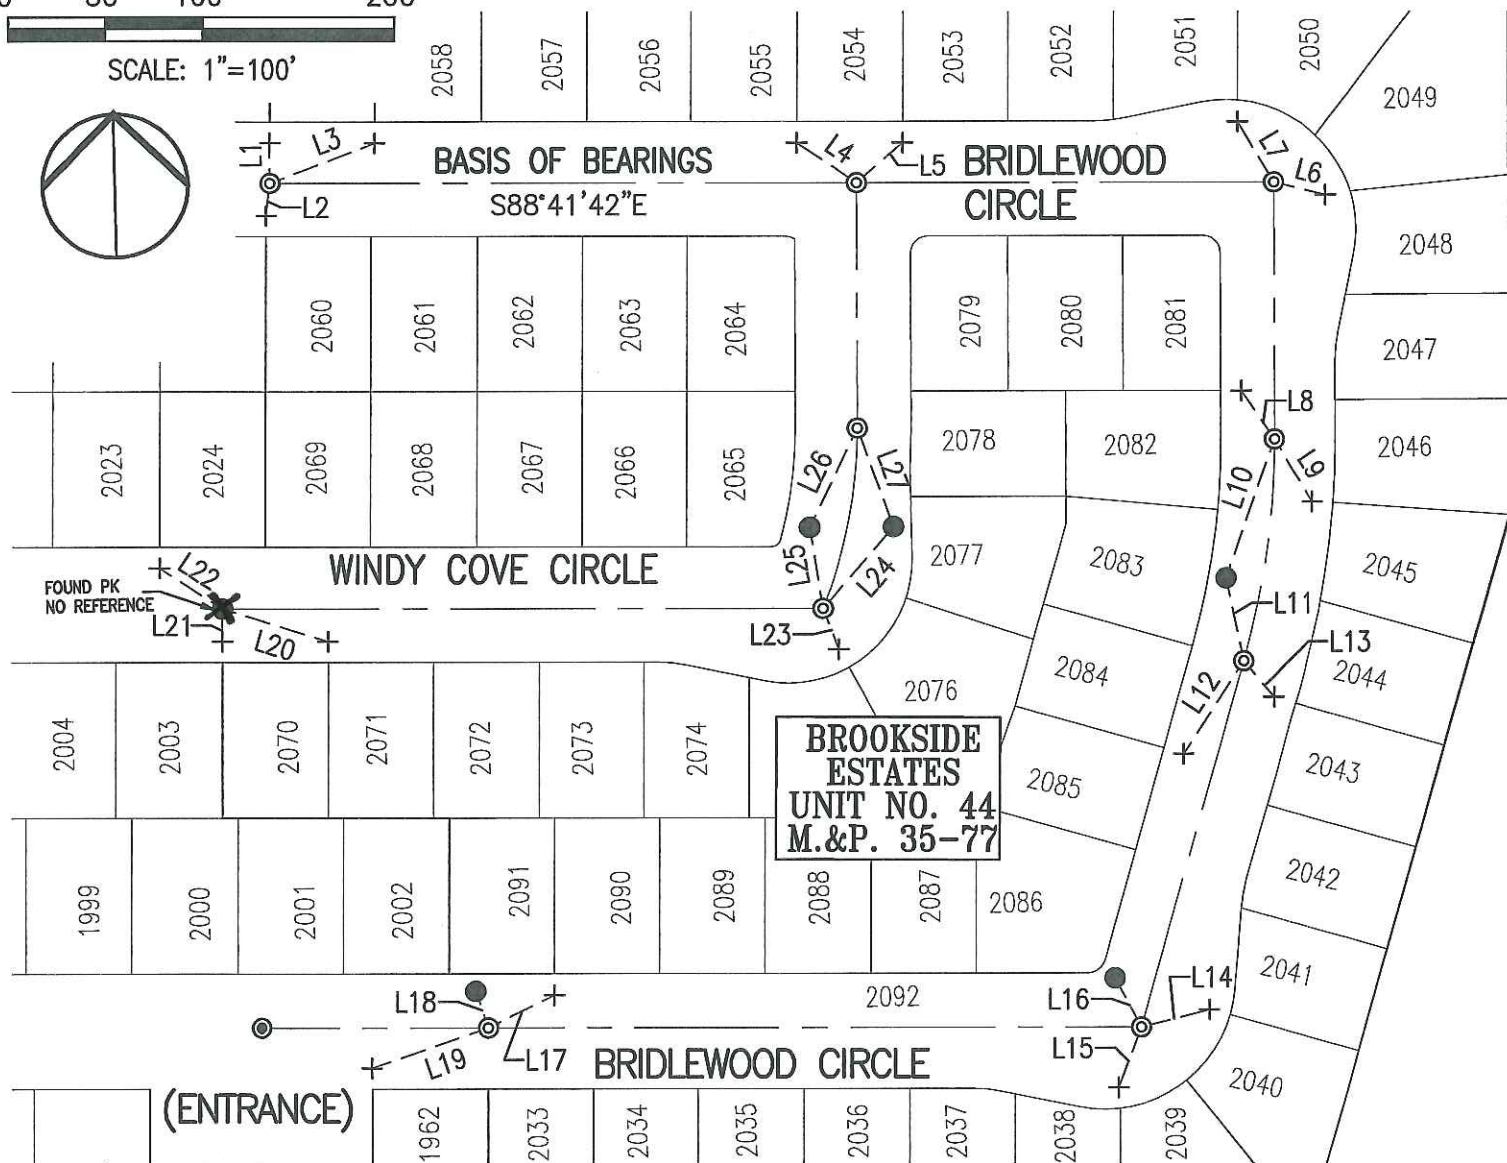

LINE TABLE		
LINE #	DIRECTION	LENGTH
L1	N1°01'17"E	21.04'
L2	N8°02'13"E	17.15'
L3	S70°20'34"W	58.73'
L4	S54°36'30"E	37.30'
L5	N50°17'41"E	31.96'
L6	S74°50'51"E	28.21'
L7	S29°26'04"E	36.88'
L8	S33°00'20"E	30.58'

LINE TABLE		
LINE #	DIRECTION	LENGTH
L9	S30°14'27"E	38.19'
L10	N20°25'25"E	76.42'
L11	N10°56'04"W	44.24'
L12	N34°10'38"E	57.56'
L13	N38°39'12"W	24.47'
L14	N77°07'13"E	36.94'
L15	N21°55'27"E	33.64'
L16	N27°08'46"W	29.15'

LINE TABLE		
LINE #	DIRECTION	LENGTH
L17	S65°09'20"W	38.54'
L18	S17°29'44"E	20.14'
L19	S72°05'01"W	63.66'
L20	N71°27'04"W	57.55'
L21	S1°10'34"W	17.09'
L22	S55°53'46"E	38.92'
L23	N19°32'07"W	22.93'
L24	S42°05'19"W	56.15'

LINE TABLE		
LINE #	DIRECTION	LENGTH
L25	N7°57'34"W	42.76'
L26	N26°38'47"E	57.12'
L27	S19°07'32"E	54.76'